



FOR LEASE

PLAZA AT THE ROUND

4145 SW WATSON • BEAVERTON, OR 97005

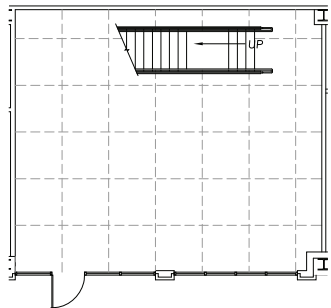


1st Floor
967 USF

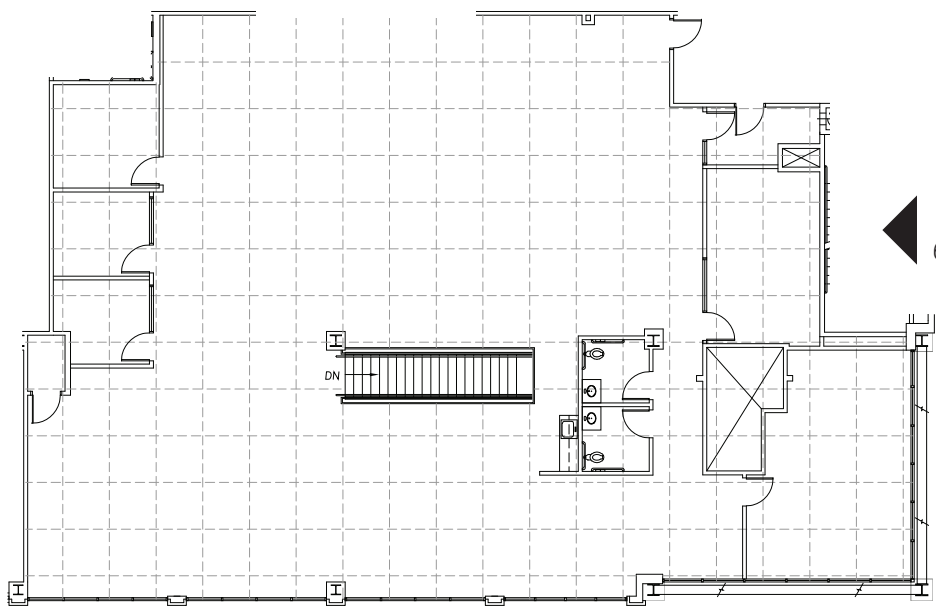

2nd Floor
6,164 RSF

As-Built

Available	Size	Lease Rate
Suite 200	7,131 RSF	Call for Rates

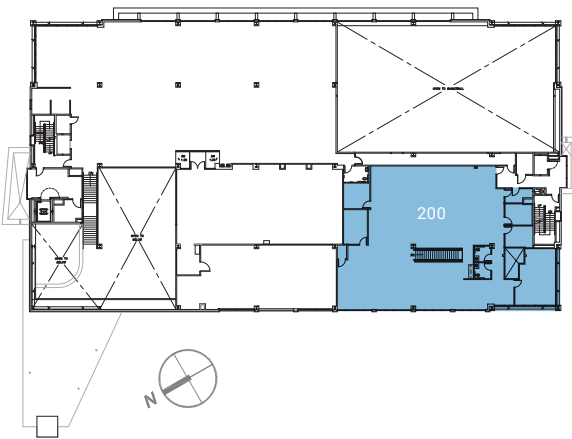

NEWMARK

For leasing information, please contact:

Josh Schweitz
Managing Director
503.970.0094
josh.schweitz@nmrk.com

Travis Parrott
Managing Director
503.972.5535
travis.parrott@nmrk.com

Trozell Benware
Brokerage Services
971.266.4956
trozell.benware@nmrk.com

The information contained herein has been obtained from sources deemed reliable but has not been verified and no guarantee, warranty or representation, either express or implied, is made with respect to such information. Terms of sale or lease and availability are subject to change or withdrawal without notice.