



411 EAST WISCONSIN CENTER

Suite 700

24,002 RSF

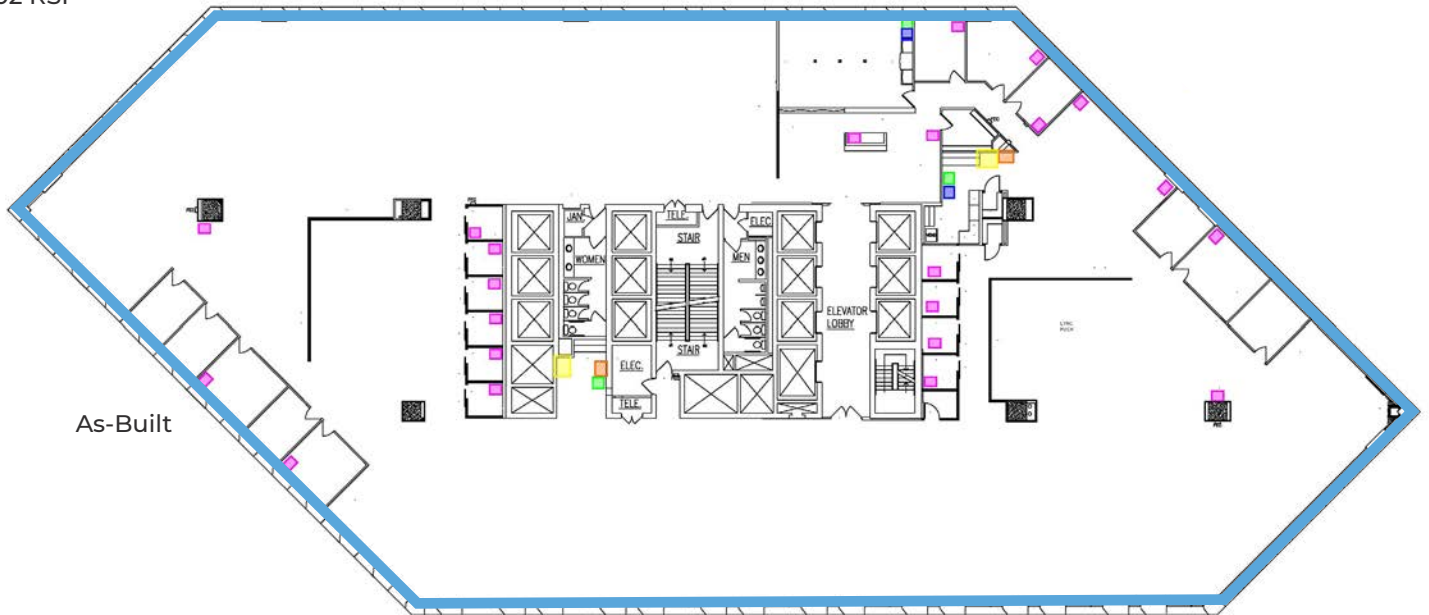

As-Built

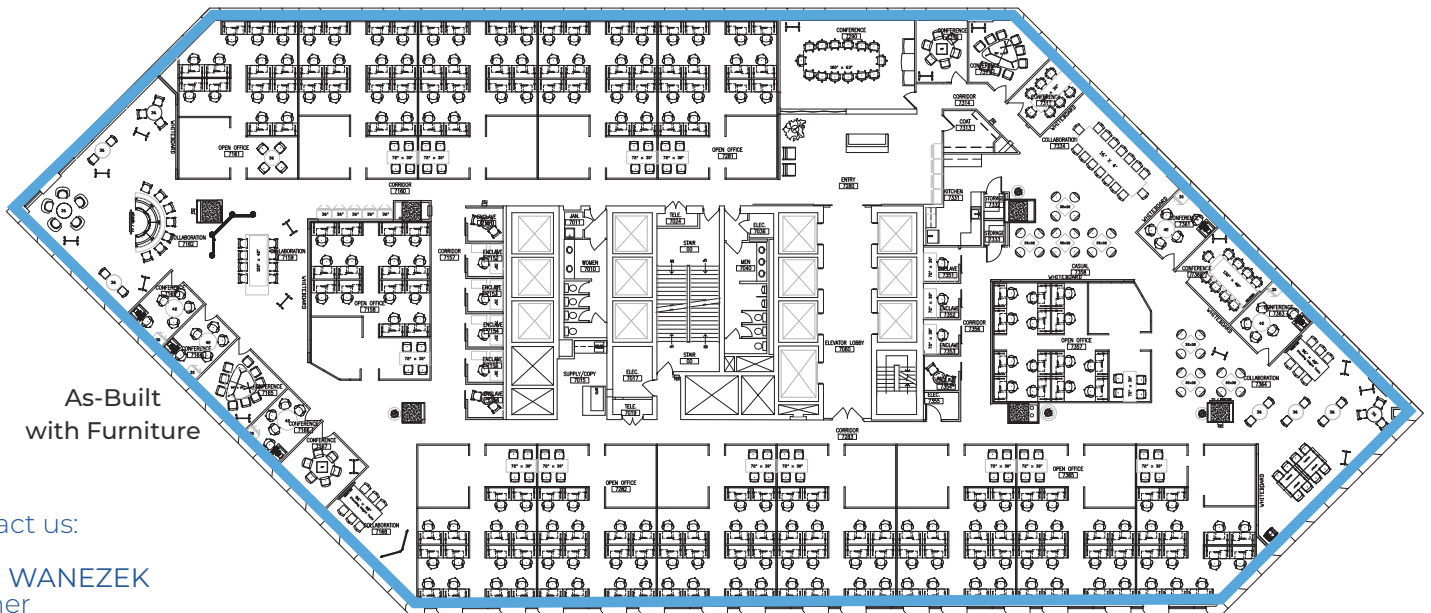

As-Built with Furniture

Contact us:

MIKE WANEZEK
Partner
+1 414 278 6826
mike.wanezek@colliers.com

JOE MORITZ
Senior Advisor
+1 414 278 6871
joe.moritz@colliers.com