

ARCHITECT



MATRIX SETTLES

1233 North Phoenix Street
Arling, VA 22204
www.matrixsettle.com
703.525.5555
CONSTRUCTION


CLIENT



PS BUSINESS PARKS

**SUITES 110 & 120
AS-BUILT
CONDITIONS**

2277 EAGLEWOOD COURT
SUITES 110, 120
STERLING, VA 20166
REF PLAN

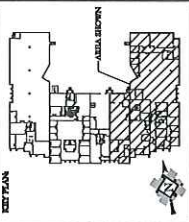

CONSTRUCTIONS

DATE	ACTION
06/11/08	ISSUED TO CLIENT

PROJECT:
SUITES 110 & 120 AS-BUILT
CONSTRUCTIONS

TITLE:
AS-BUILT


SCALE: 1/8"=1'-0"

DATE: 06/11/08

CREATED FILE NO.: AS-BUILT.dwg

PROJECT NO.: 471-004

SHEET NO.: S-1

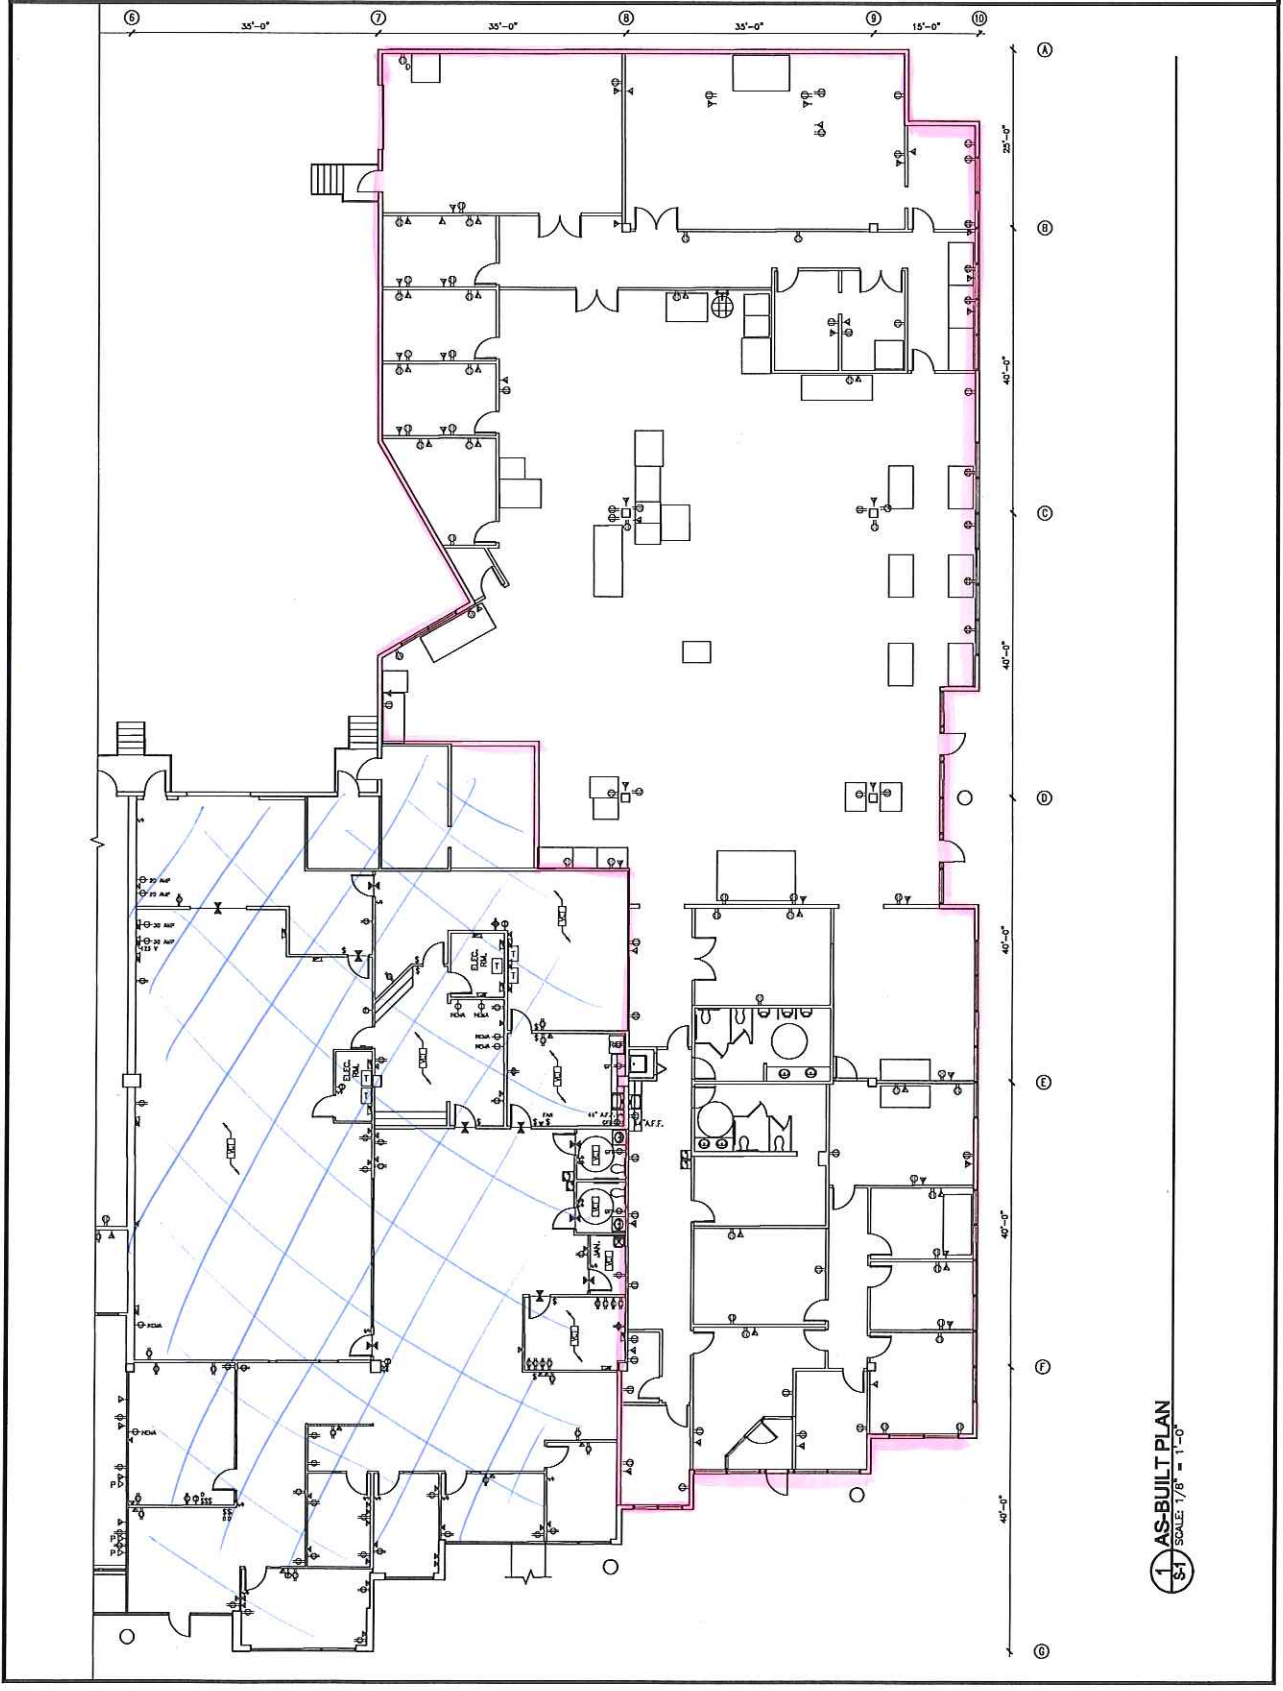

1 AS-BUILT PLAN
SCALE: 1/8" = 1'-0"