
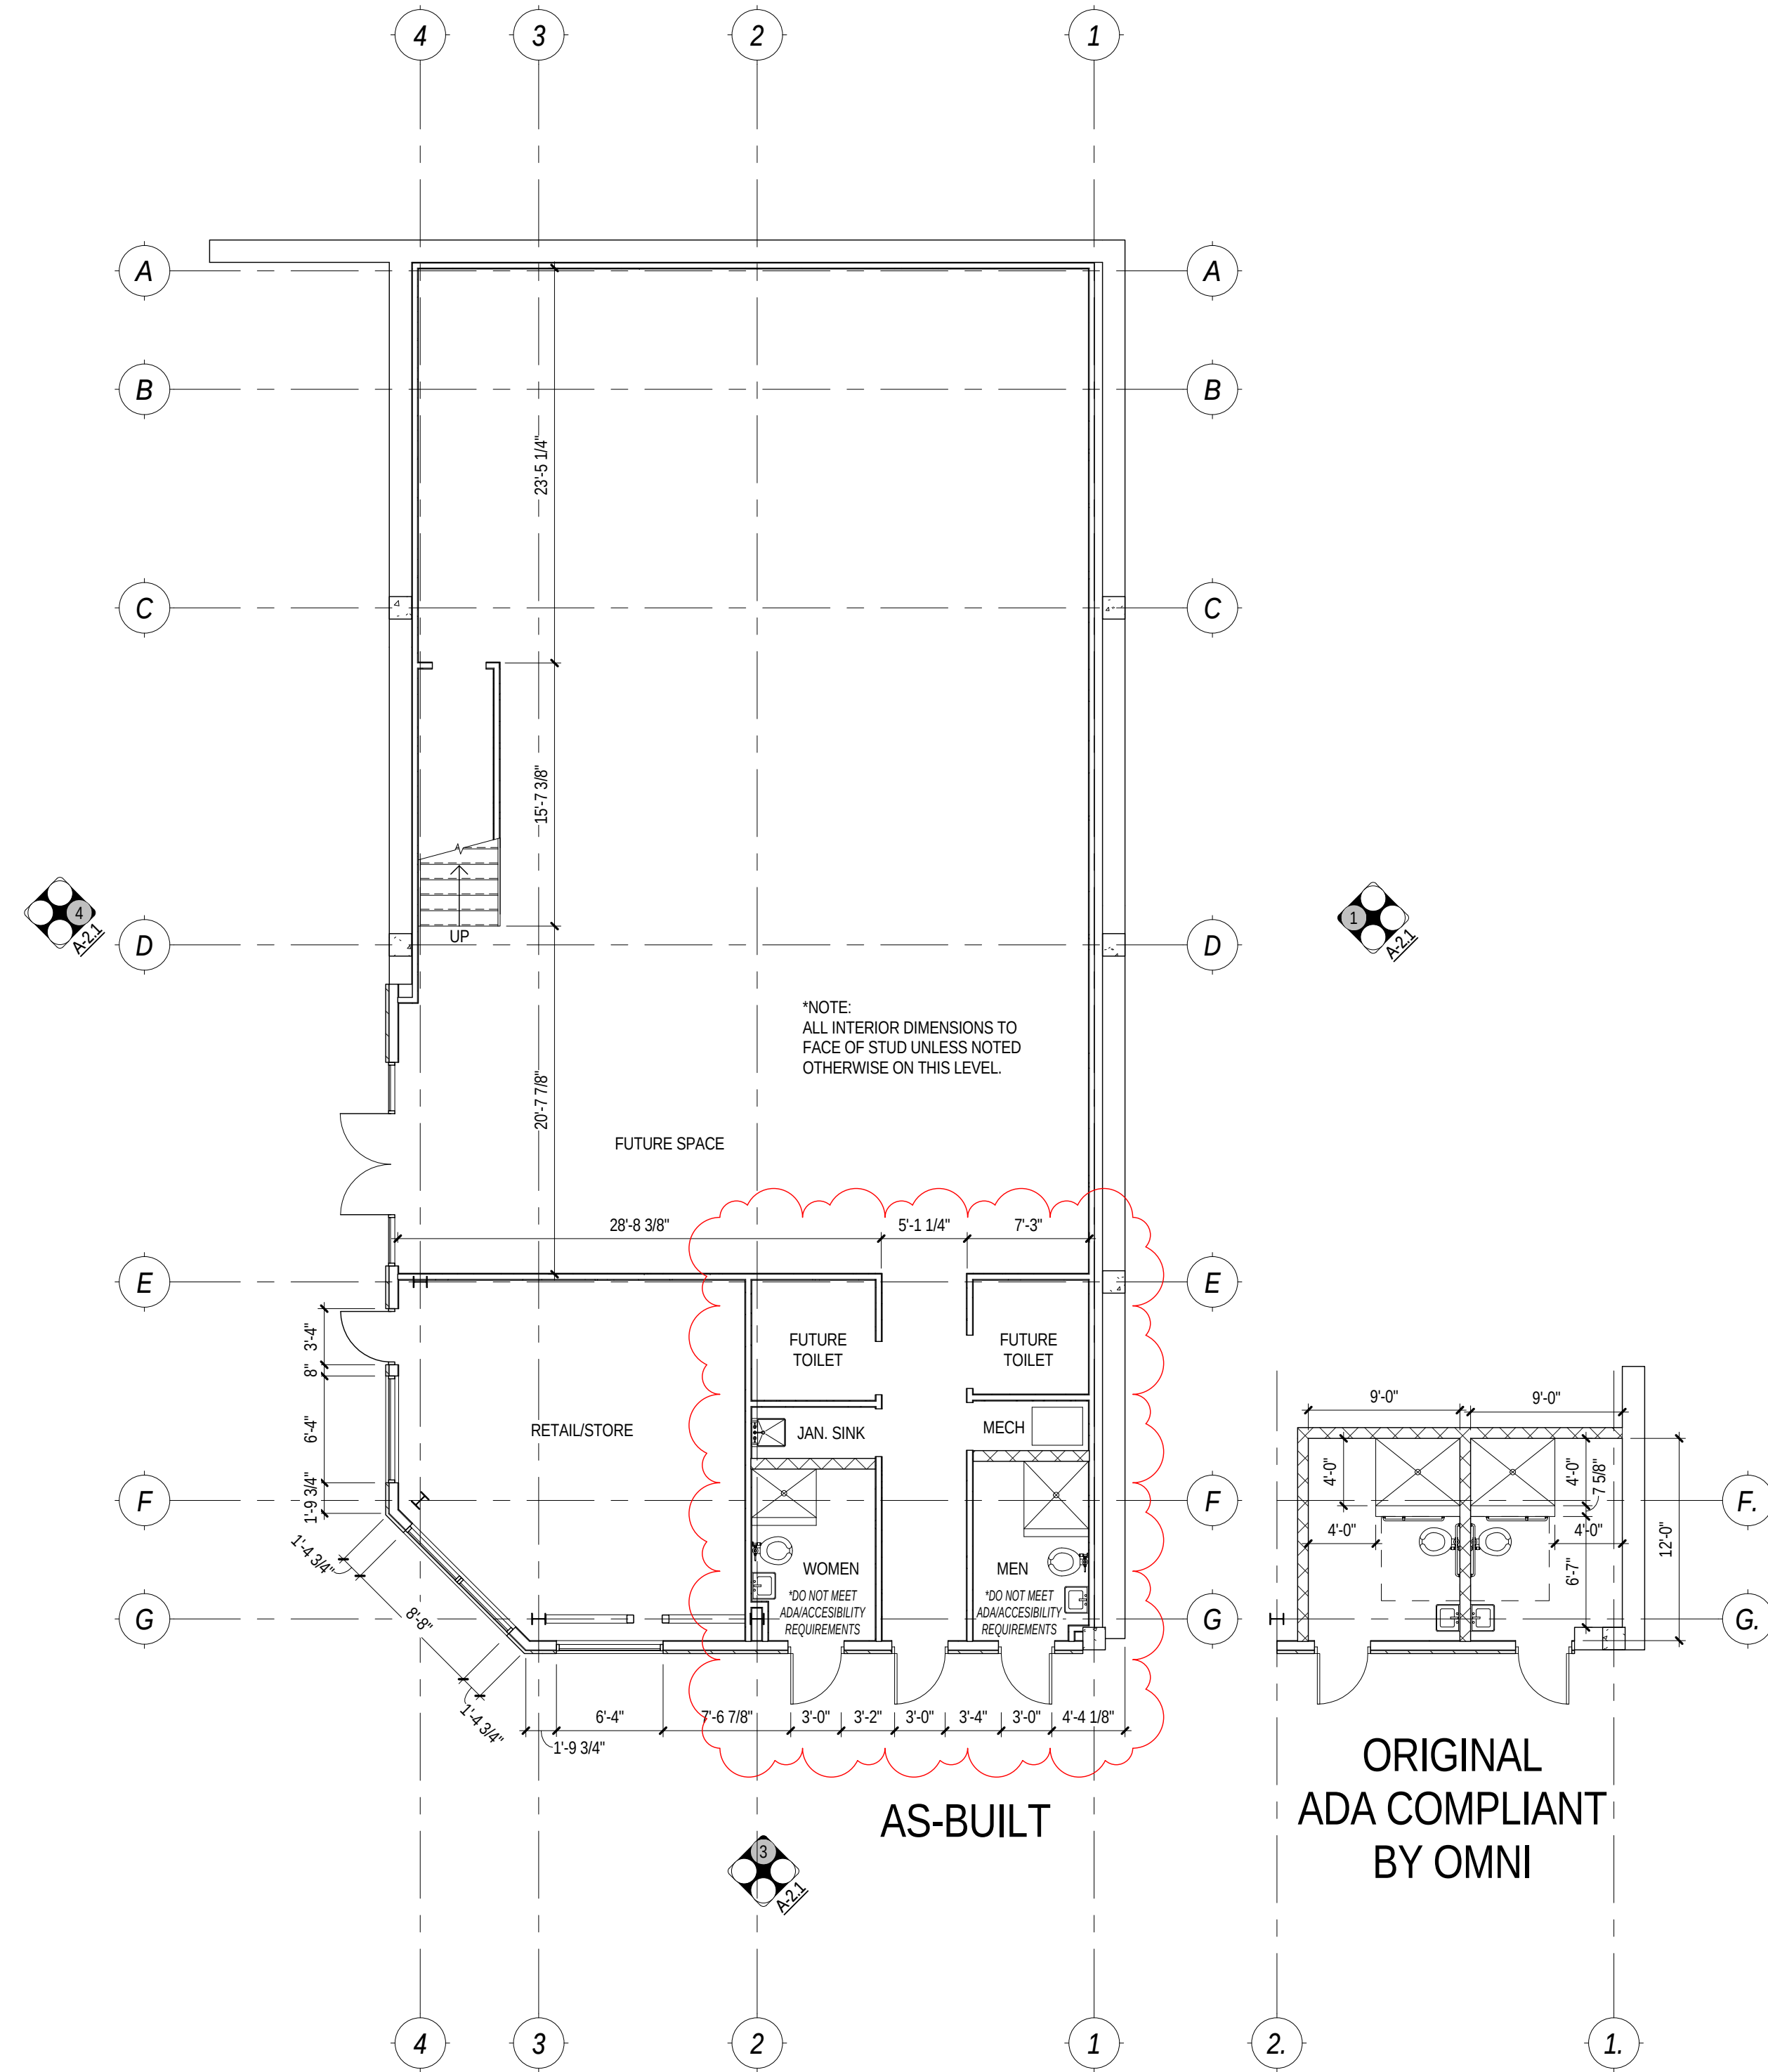
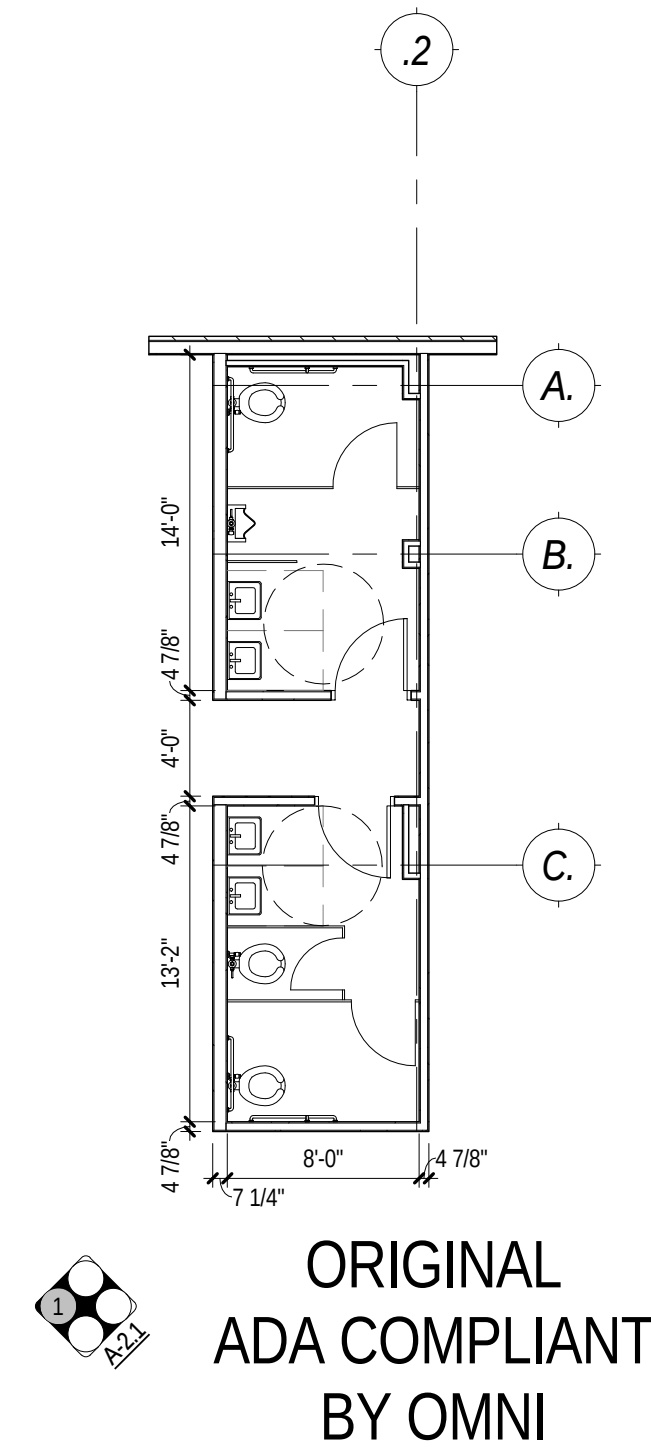


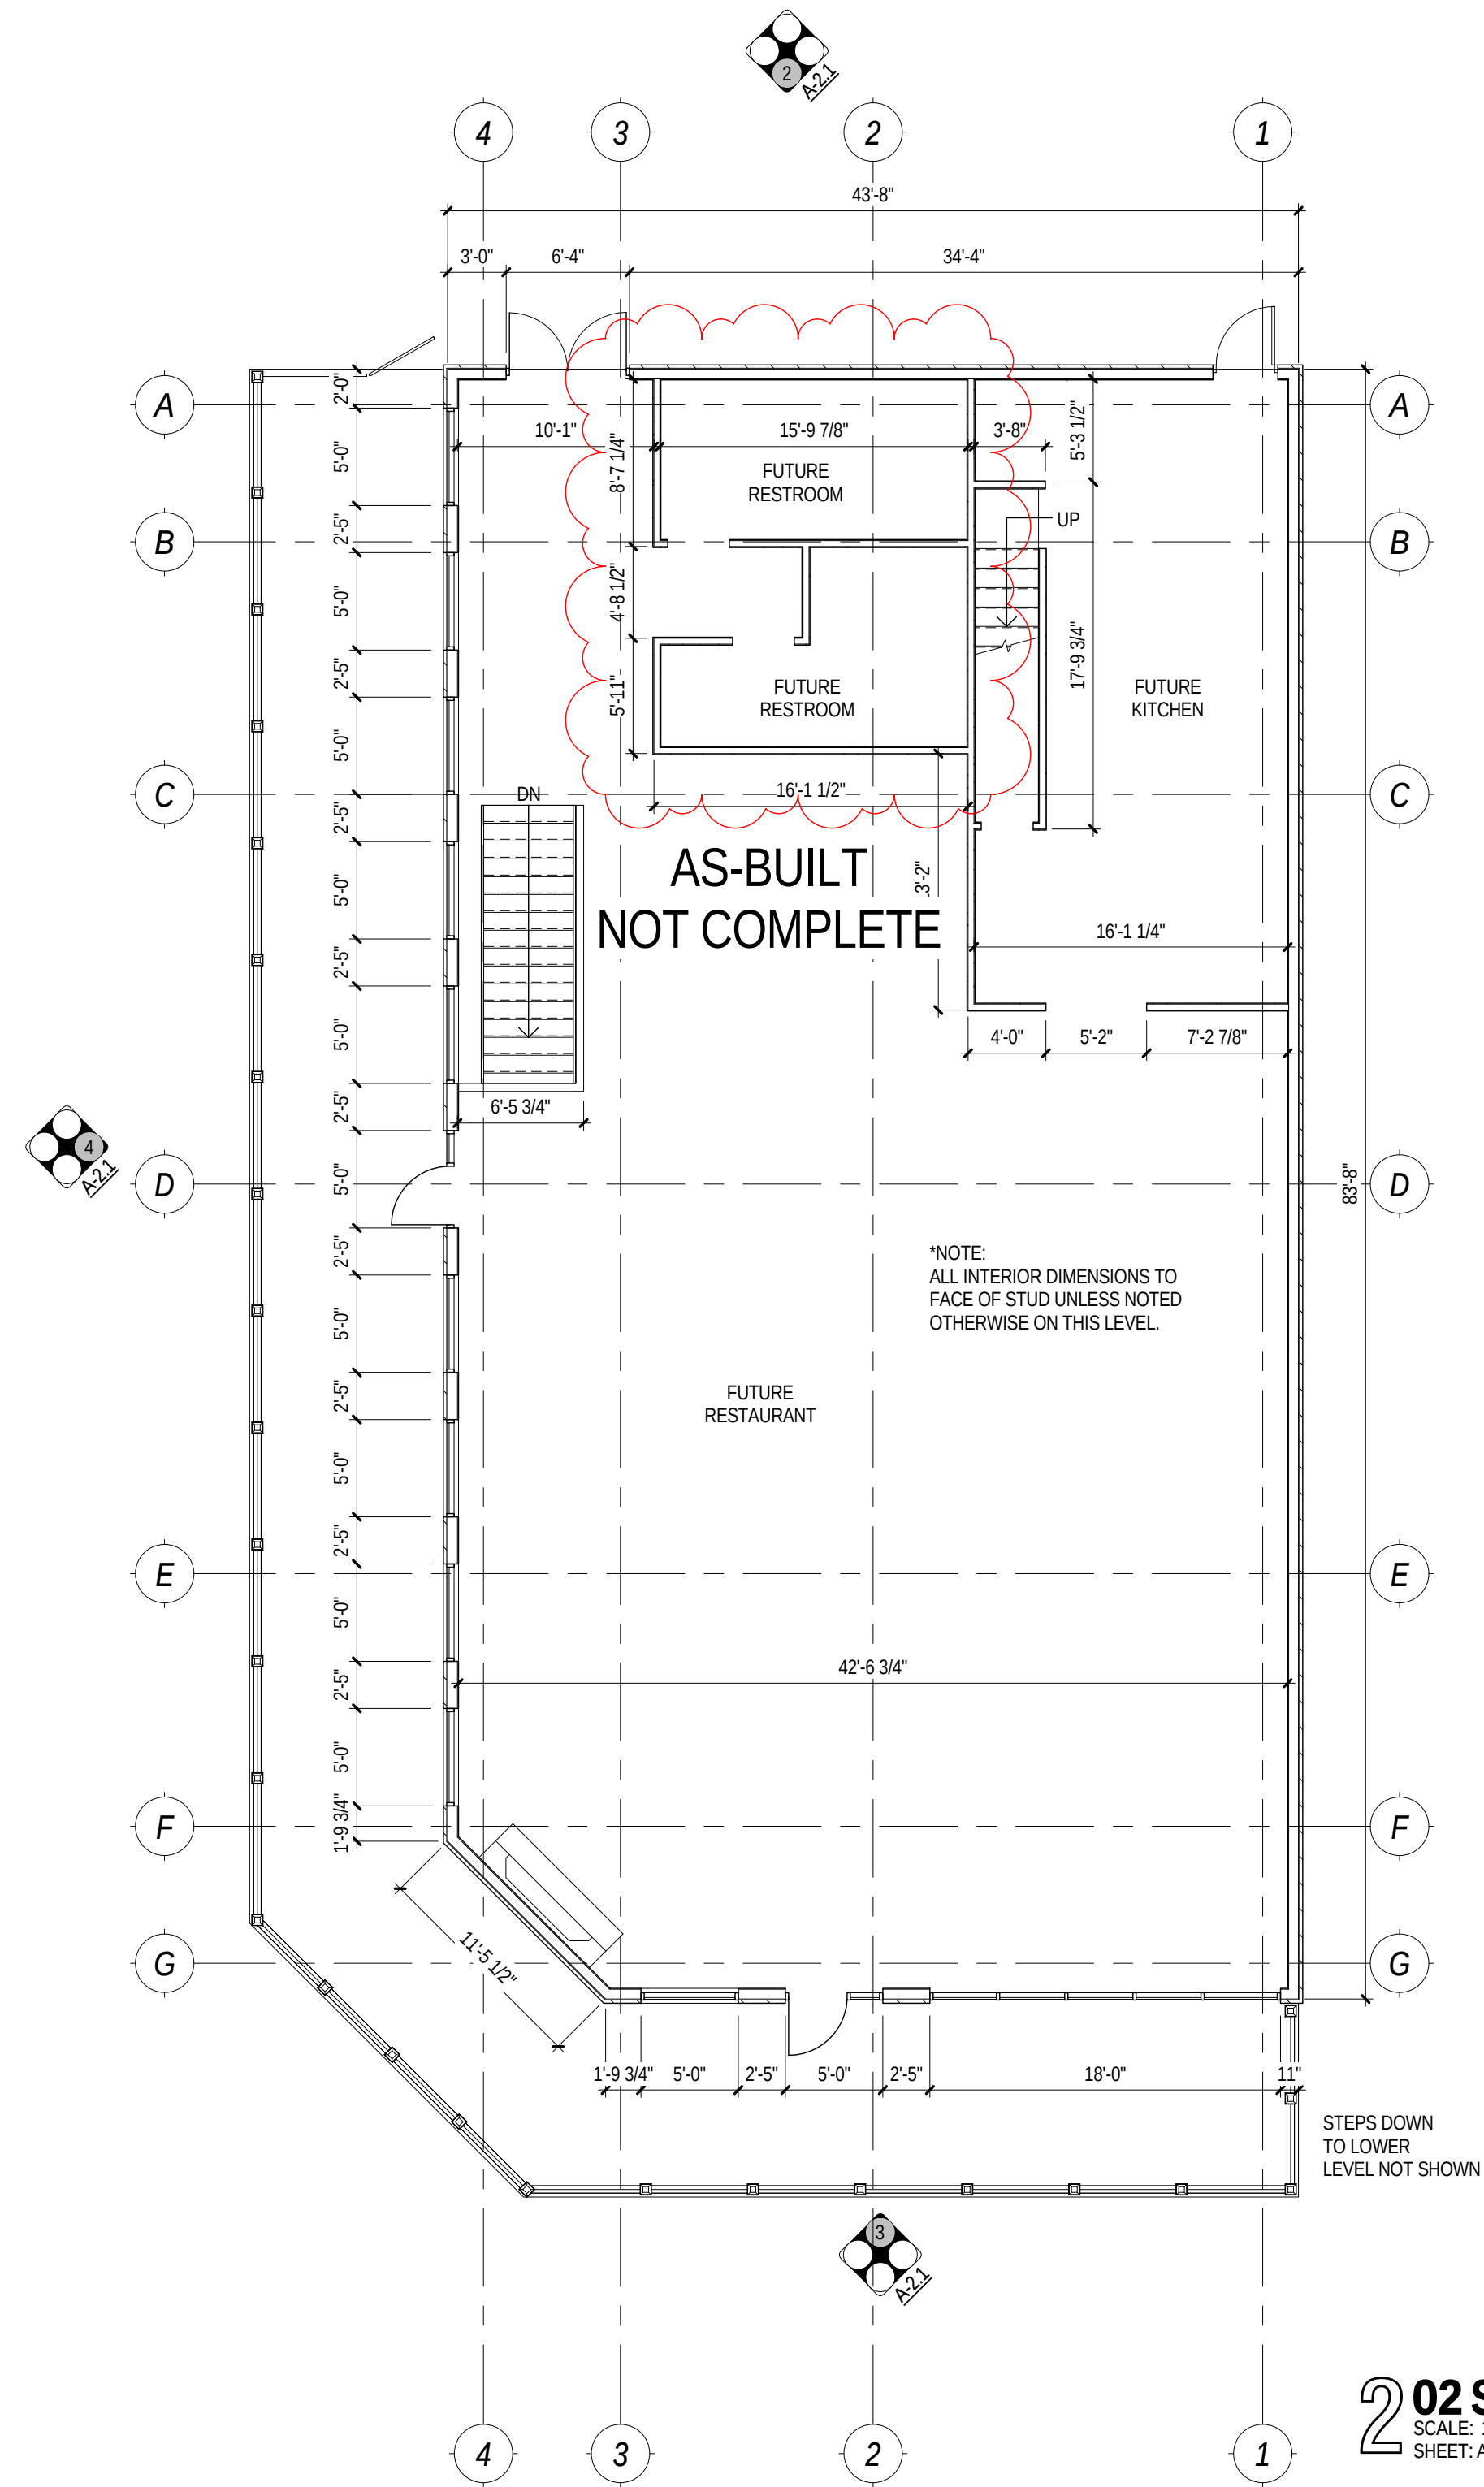

1	Date 1	Revision 1
REVISIONS		

Marina Restaurant
Cheat Lake
Morgantown, WV

AS-BUILT DOCUMENT
03.03.15

omni
associates
architects
1543 FAIRMONT AVENUE
FAIRMONT, WV 26554
(toll free) 855.367.1417
omni411.com

omni

FLOOR PLAN

A-1.1

COPYRIGHT: © ALL RIGHTS RESERVED. REPRODUCTION IN WHOLE OR IN PART IS PROHIBITED. THIS DRAWING IS AN INSTRUMENT OF SERVICE. IS THE PROPERTY OF THE ARCHITECT AND MAY NOT BE USED IN ANY WAY WITHOUT WRITTEN PERMISSION OF THIS FIRM.
PROJECT No. 23349 DRAWN BY: RQ

AS-BUILT DOCUMENT