




9144 ARROWPOINT BLVD. | CHARLOTTE, NC 28273

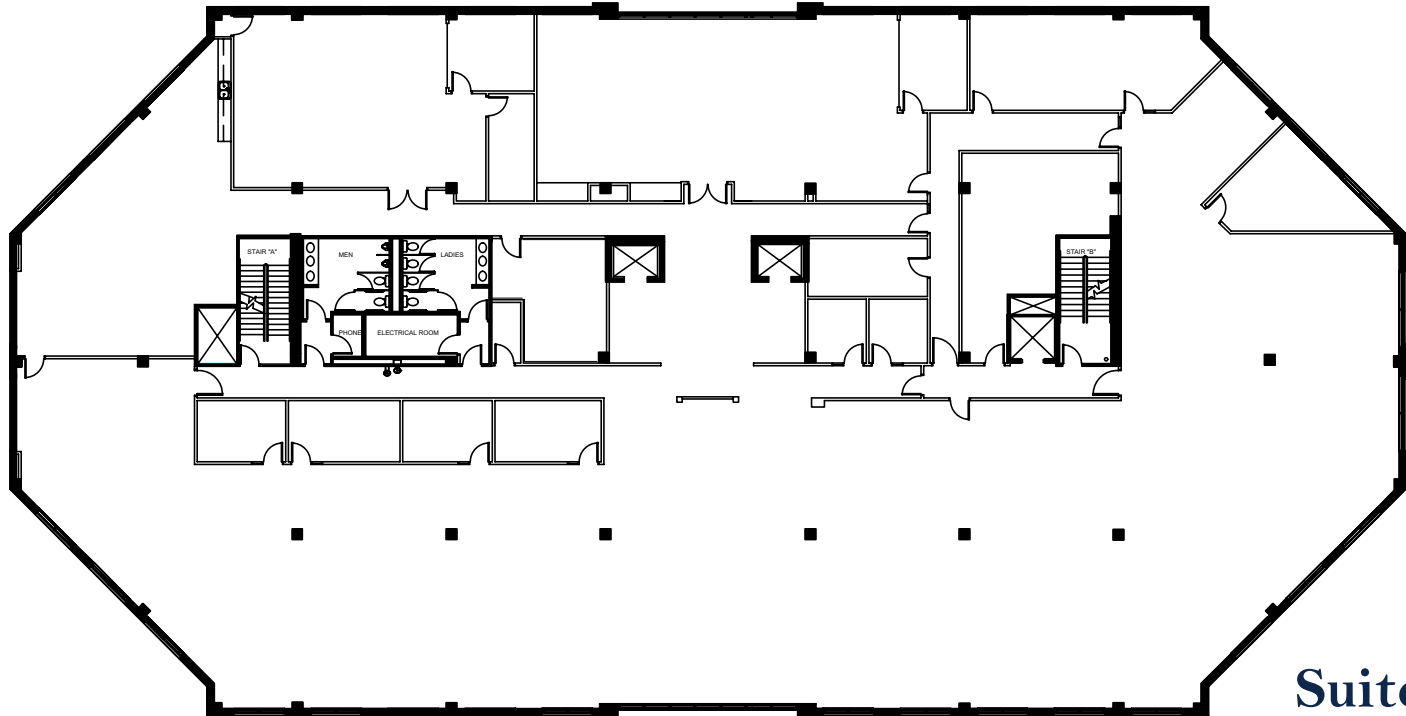

Suite 300
22,549 SF

FOR LEASING INQUIRIES PLEASE CONTACT STREAM REALTY PARTNERS:

BOB BOYKIN

bob.boykin@streamrealty.com

980-819-4274

GRANT KEYES

grant.keyes@streamrealty.com

980-378-1521

