

ESTRELLA
MEDICAL
CENTER

9305 W THOMAS RD | PHOENIX, AZ 85037


Floor 03

Suite 385

AS-BUILT

2,096 SF

AVAILABLE

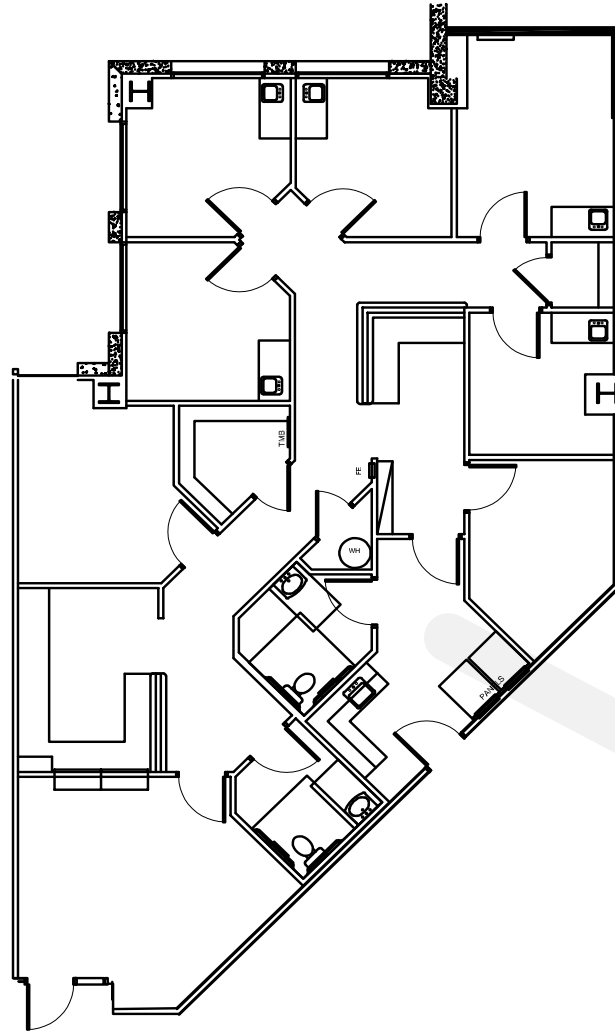

RACHAEL THOMPSON
Senior Vice President
602.513.5122
rachael.thompson@kidder.com

PERRY GABUZZI, CCIM
Senior Vice President
602.513.5116
perry.gabuzzi@kidder.com



View Portfolio

km Kidder
Mathews

ESTRELLA
MEDICAL
CENTER

9305 W THOMAS RD | PHOENIX, AZ 85037


Floor 04

Suite 455

AS-BUILT

1,721 SF

AVAILABLE

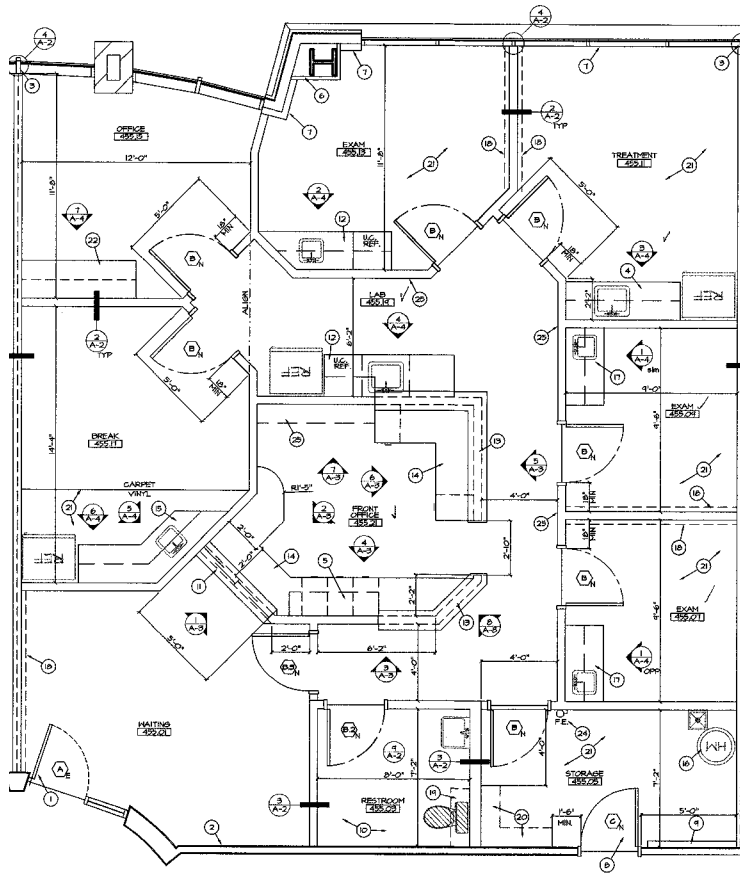

RACHAEL THOMPSON
Senior Vice President
602.513.5122
rachael.thompson@kidder.com

PERRY GABUZZI, CCIM
Senior Vice President
602.513.5116
perry.gabuzzi@kidder.com



View Portfolio

km Kidder
Mathews

ESTRELLA
MEDICAL
CENTER

9305 W THOMAS RD | PHOENIX, AZ 85037


Floor 04

Suite 490

AS-BUILT

1,401 SF

AVAILABLE

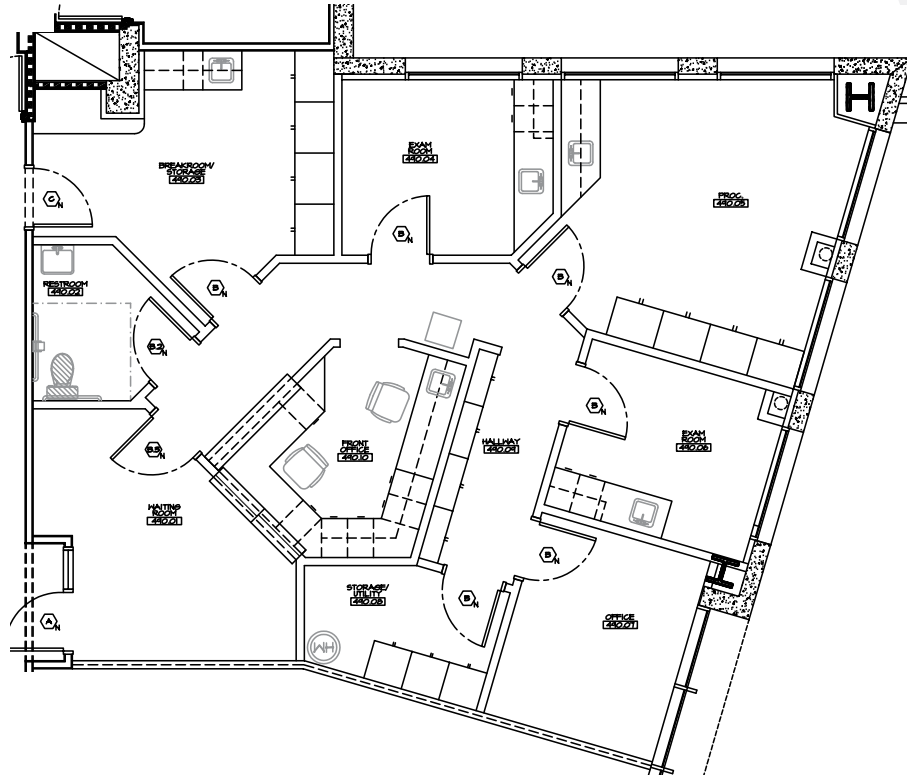

RACHAEL THOMPSON
Senior Vice President
602.513.5122
rachael.thompson@kidder.com

PERRY GABUZZI, CCIM
Senior Vice President
602.513.5116
perry.gabuzzi@kidder.com



View Portfolio

km Kidder
Mathews

ESTRELLA
MEDICAL
CENTER

9305 W THOMAS RD | PHOENIX, AZ 85037

Floor 05

Suite 550


AS-BUILT

Suite 550

AS-BUILT

2,810 SF
AVAILABLE

2,810 SF
AVAILABLE

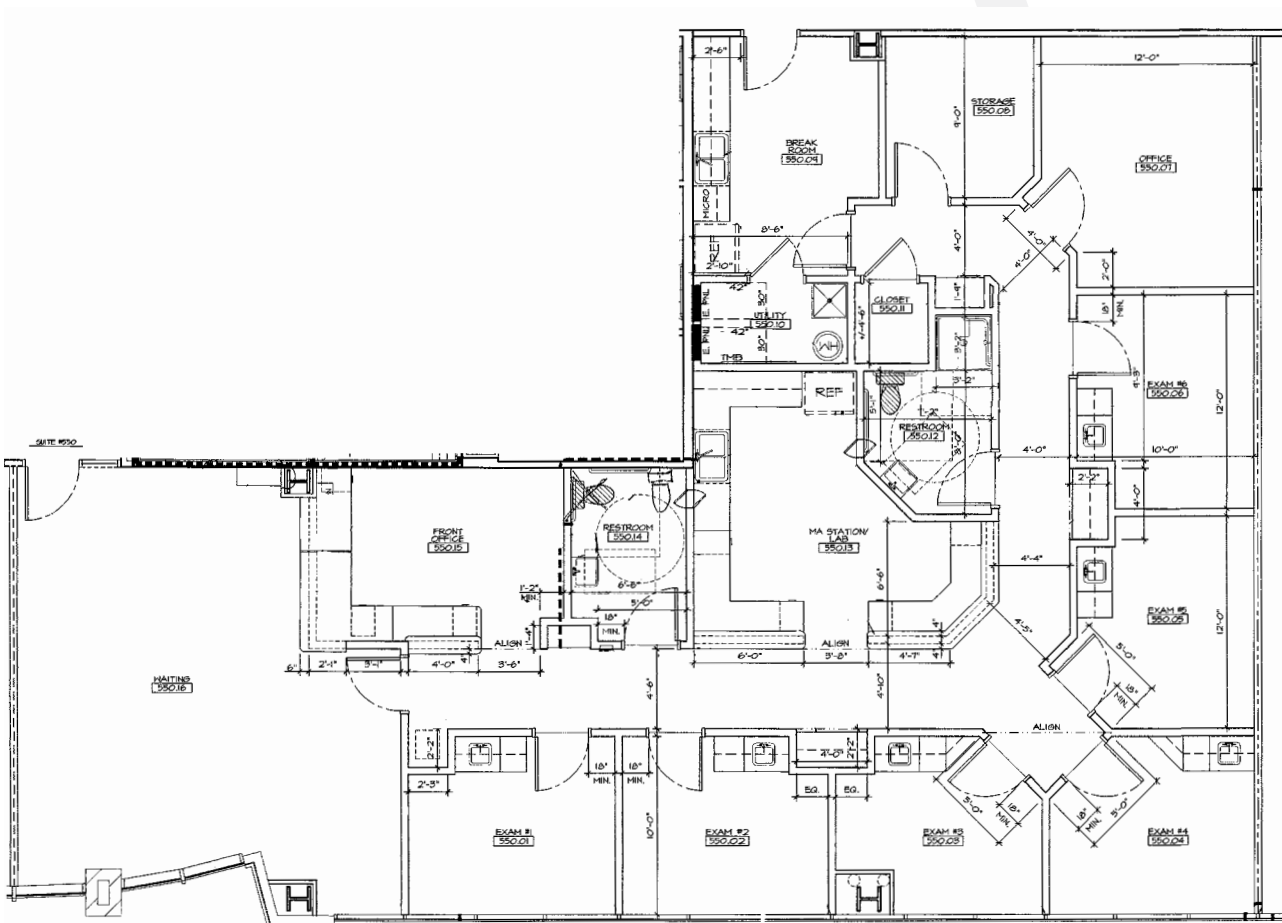

RACHAEL THOMPSON
Senior Vice President
602.513.5122
rachael.thompson@kidder.com

PERRY GABUZZI, CCIM
Senior Vice President
602.513.5116
perry.gabuzzi@kidder.com

[View Portfolio](#)

**Kidder
Mathews**

ESTRELLA
MEDICAL
CENTER

Floor 05

Suite 560

AS-BUILT


1,327 SF

AVAILABLE

RACHAEL THOMPSON
Senior Vice President
602.513.5122
rachael.thompson@kidder.com

PERRY GABUZZI, CCIM
Senior Vice President
602.513.5116
perry.gabuzzi@kidder.com

9305 W THOMAS RD | PHOENIX, AZ 85037

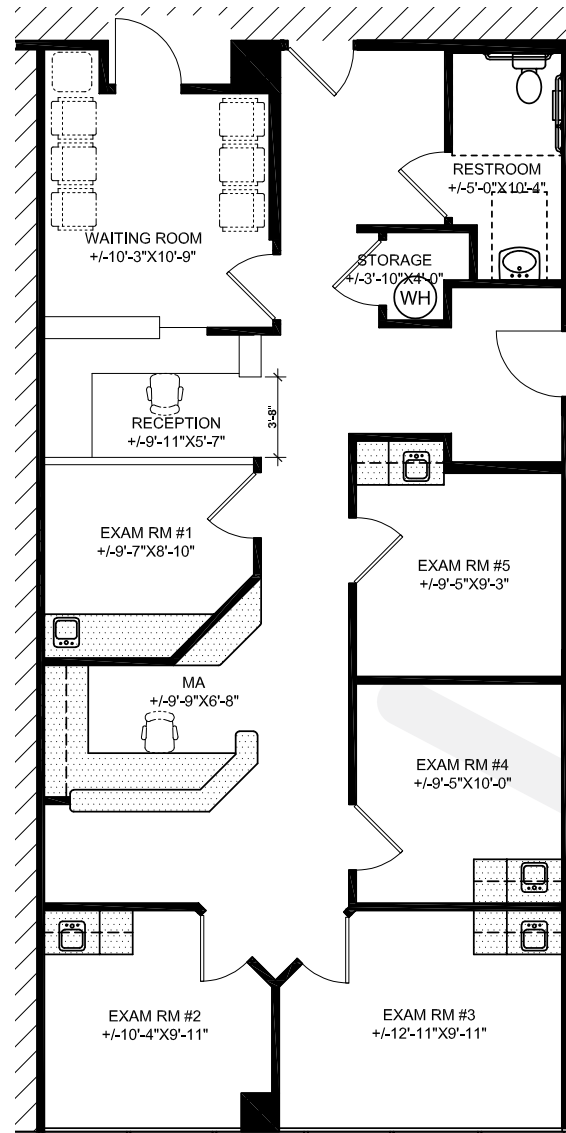

View Portfolio

ESTRELLA
MEDICAL
CENTER

9305 W THOMAS RD | PHOENIX, AZ 85037


Floor 05

Suite 570

AS BUILT

2,121 SF

AVAILABLE

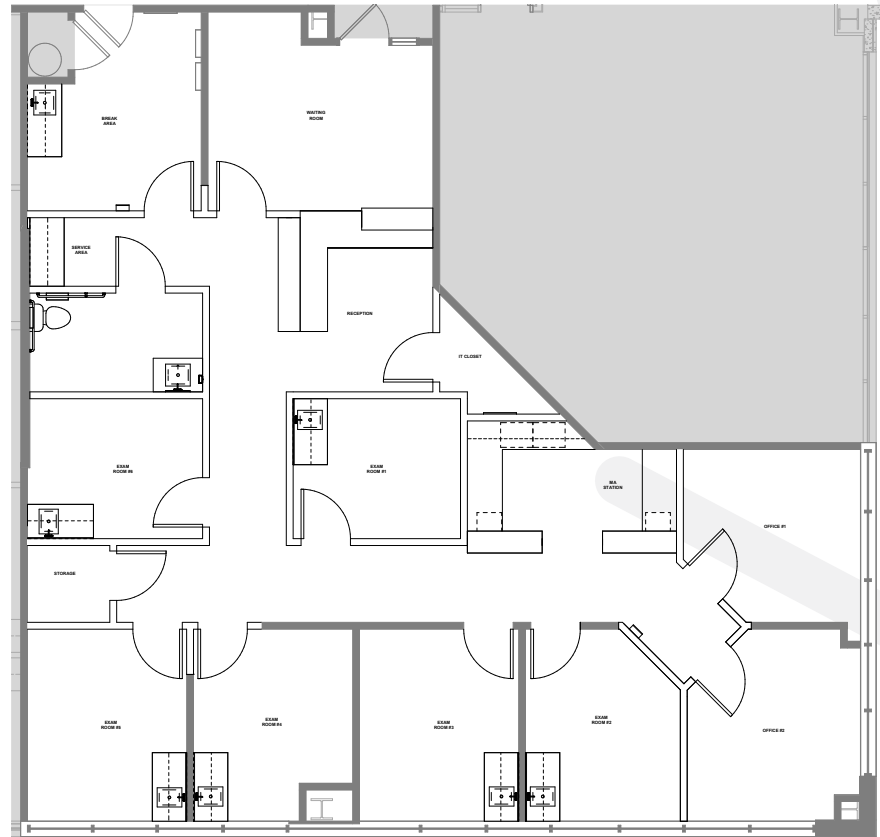

RACHAEL THOMPSON
Senior Vice President
602.513.5122
rachael.thompson@kidder.com

PERRY GABUZZI, CCIM
Senior Vice President
602.513.5116
perry.gabuzzi@kidder.com



View Portfolio

km Kidder
Mathews

ESTRELLA
MEDICAL
CENTER

9305 W THOMAS RD | PHOENIX, AZ 85037


Floor 05

Suites 560
& 570

AS-BUILT

3,448 SF

AVAILABLE

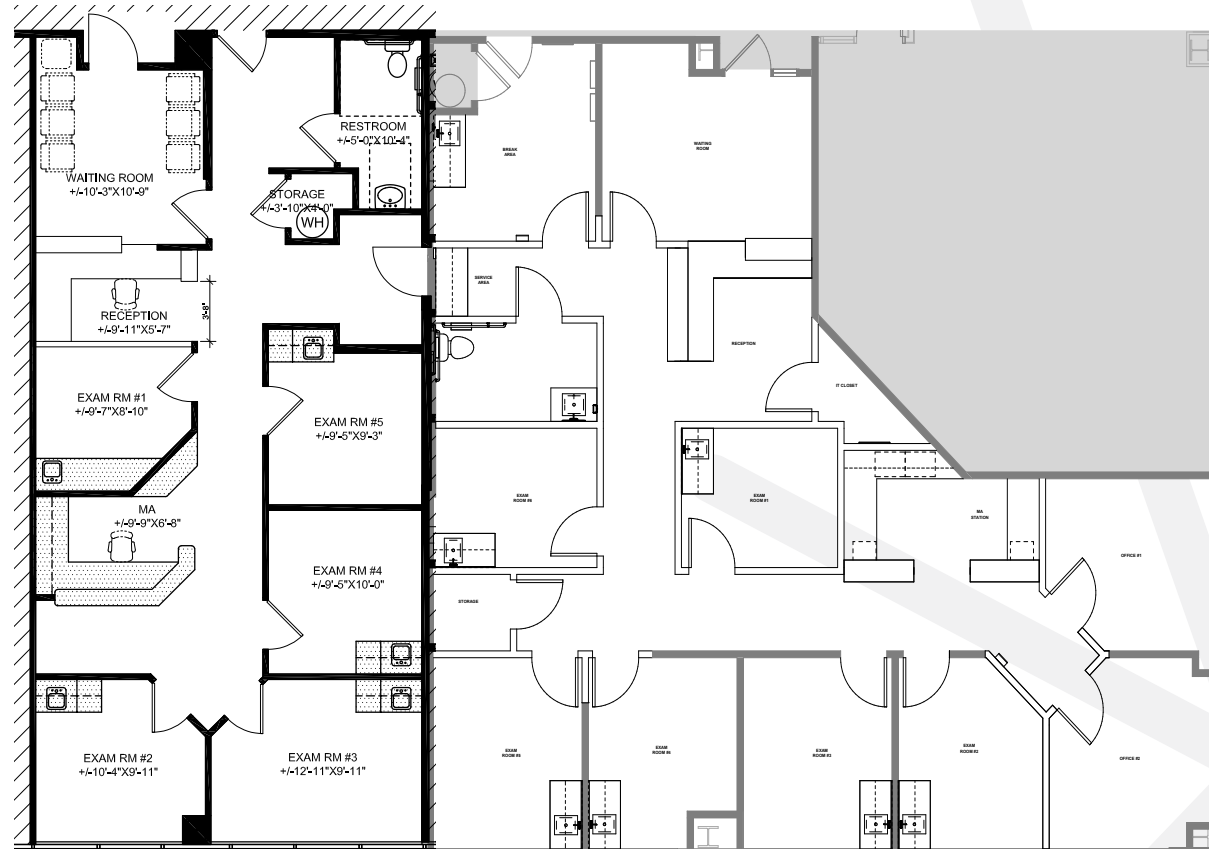

RACHAEL THOMPSON
Senior Vice President
602.513.5122
rachael.thompson@kidder.com

PERRY GABUZZI, CCIM
Senior Vice President
602.513.5116
perry.gabuzzi@kidder.com



View Portfolio

km Kidder
Mathews

ESTRELLA
MEDICAL
CENTER

9305 W THOMAS RD | PHOENIX, AZ 85037


Floor 05

Suite 585

AS-BUILT

1,574 SF

AVAILABLE

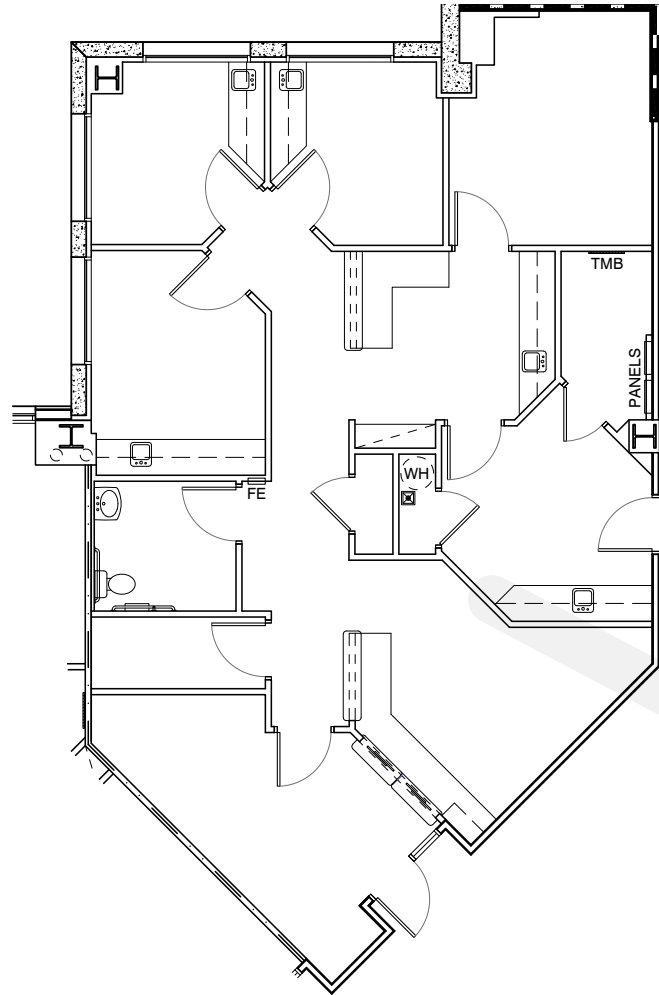

RACHAEL THOMPSON
Senior Vice President
602.513.5122
rachael.thompson@kidder.com

PERRY GABUZZI, CCIM
Senior Vice President
602.513.5116
perry.gabuzzi@kidder.com



View Portfolio

km Kidder
Mathews