



DOCUMENTATION & DETAILING

Plan A Services Inc.

70 Gilbert St,  
Monroe, NY 10950

718.219.4749

info@planaservices.com  
planaservices.com

# Project

203 E 109th St,  
New York, NY 10029

# Drawing

Space plan

**A** **B** | As-built  
Floor Plans

# A - 001.01


Area 1809 sq.ft.

Scale 1/4":1'


Date 11/4/2024

Drawn By M.O.

Notes

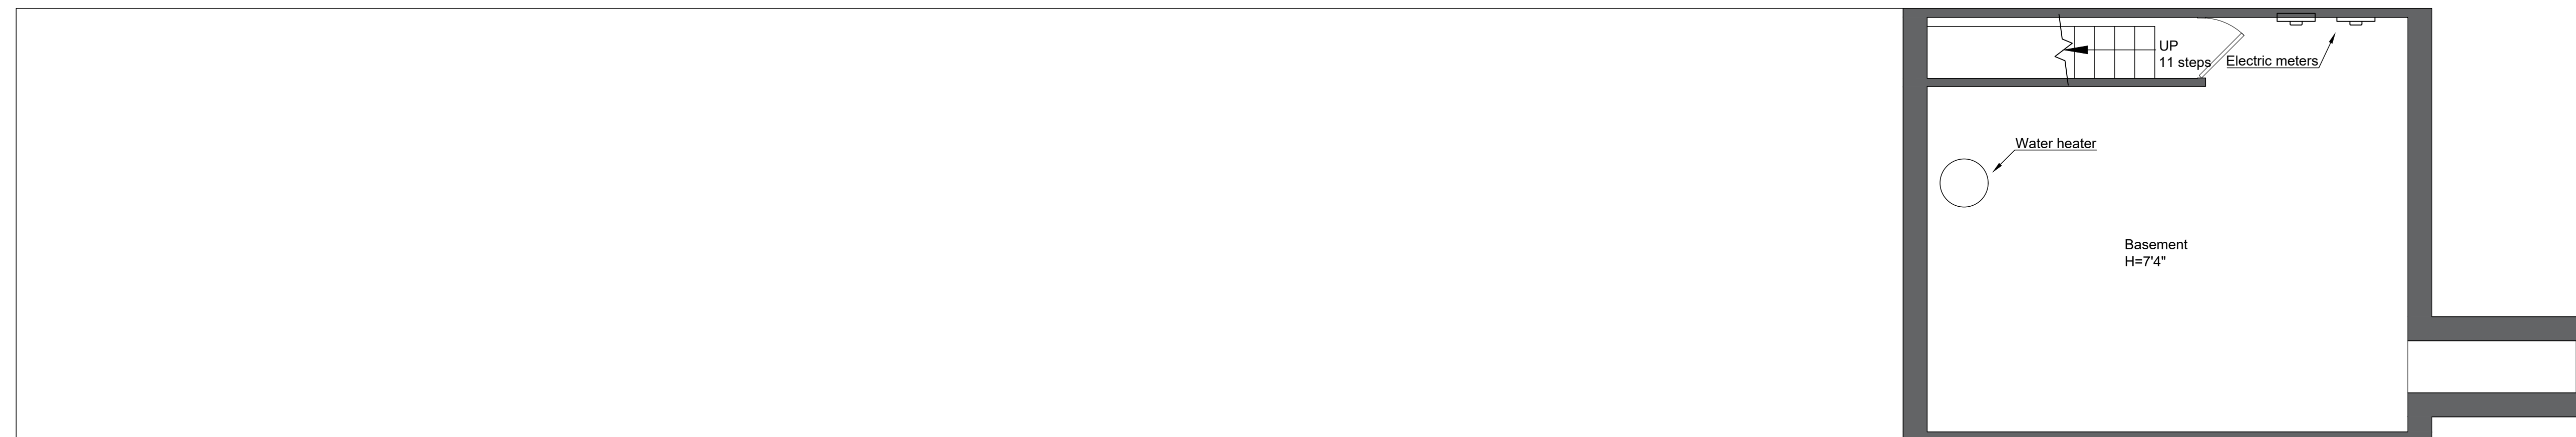

1 Basement  
Scale: 1/4":1'

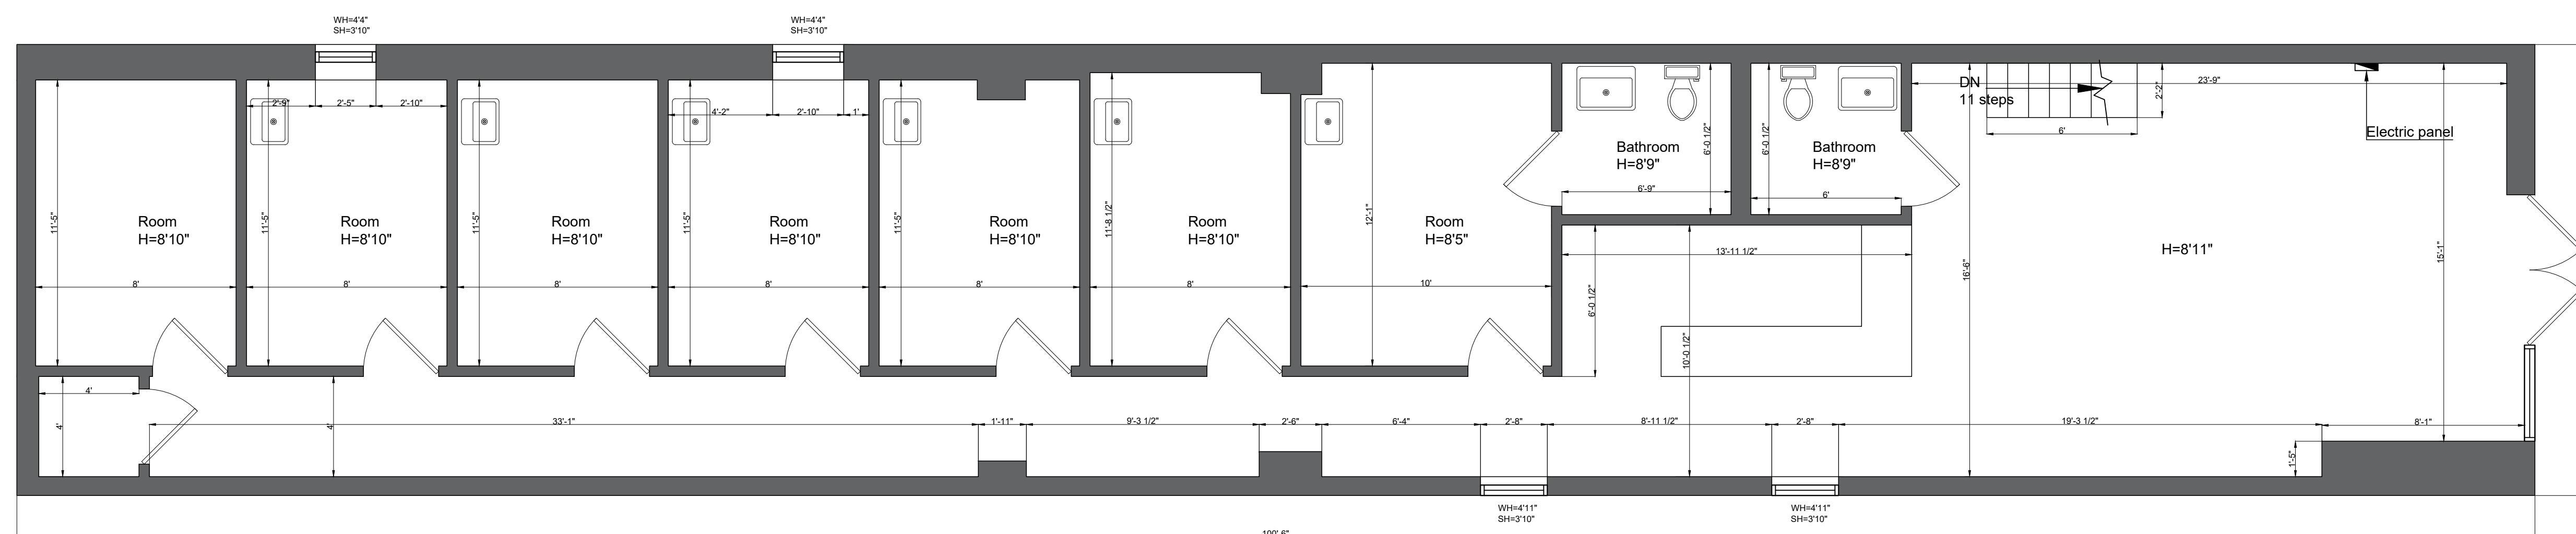

2 First floor  
Scale: 1/4":1'