


SHEA MEDICAL PLAZA

7425 E SHEA BLVD, SCOTTSDALE, AZ 85260

FOR LEASE

SUITE 114 - 2,729 SF

AS BUILT

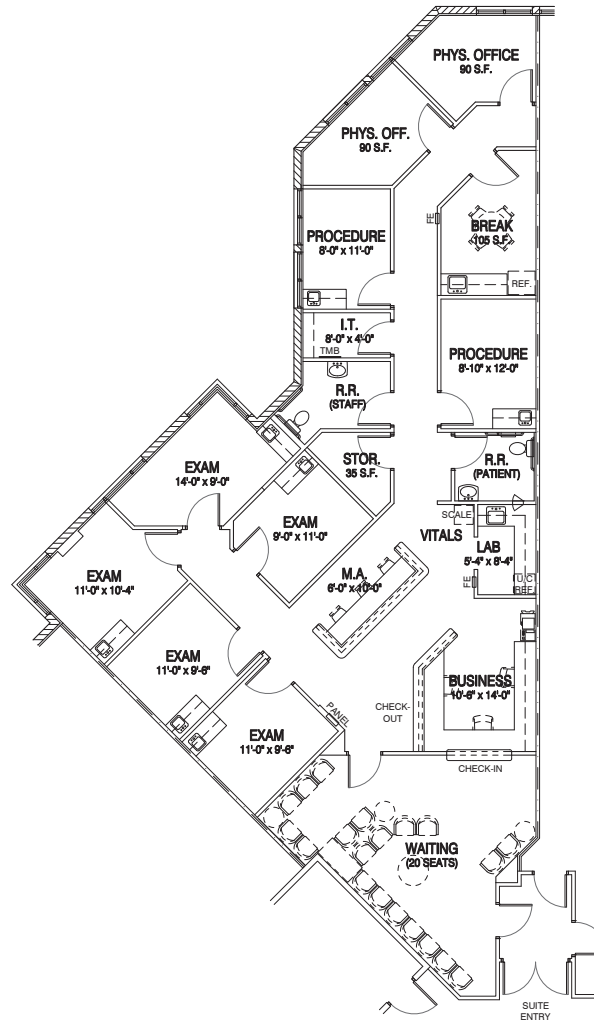

RACHAEL THOMPSON
602.513.5122
rachael.thompson@kidder.com

PERRY GABUZZI
602.513.5116
perry.gabuzzi@kidder.com

kidder.com

