


AREA TABULATION

UNIT 105 LEASABLE SPACE = 1957 S.F.

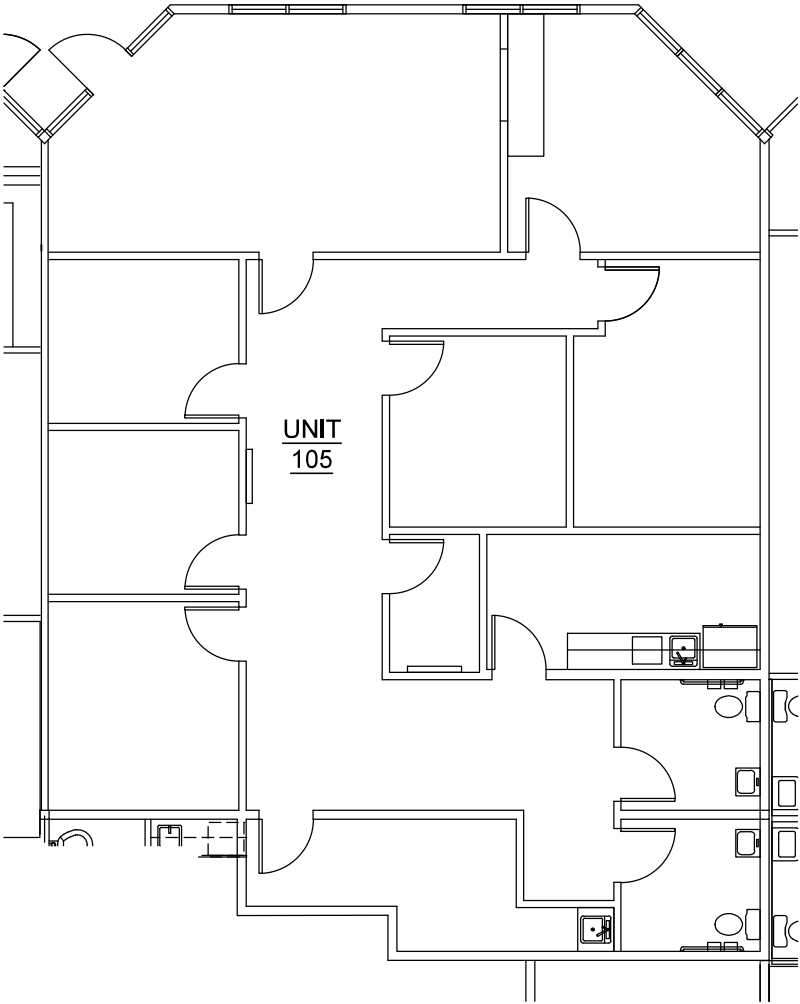

1 UNIT 105 AS-BUILT PLAN
A1.00 SCALE: 3/32" = 1'-0"

REVISIONS	#	DATE	DESCRIPTION	DRAFTER INFORMATION	PROPERTY OWNER:	PROJECT INFORMATION	PROJECT NAME:	DRAWING INFORMATION	PLOT DATE:
					RENO JONES, LLC		RENO JONES OFFICE SUITES		09-17-2024
					COMPANY ADDRESS:		PROJECT ADDRESS:		PHASE
					5052 SOUTH JONES BOULEVARD LAS VEGAS, NEVADA 89118		5052 SOUTH JONES BOULEVARD LAS VEGAS, NEVADA 89118		AS-BUILT SUBMITTAL
					COMPANY CONTACT:		PROJECT NUMBER:		SHEET NAME
			LOUIS CARNESALE 702-466-0444	002-01-24-002	AS-BUILT FLOOR PLAN				
						SHEET NO.			
						A1.00			