


**01 FLOOR PLAN**  
 SCALE: 1/4" = 1'-0"

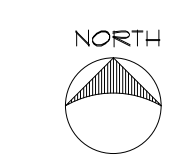

EXISTING TOTAL LEASE  
 SPACE  
 AREA = +/- 2,472 SF

OSBORN & VANE ARCHITECTS INC

2000 Bering Drive, Suite 410  
 Houston, Texas 77057  
 713 781 5262  
 Fax 713 781 5347  
 Members American Institute of Architects



AS BUILT

BLAKE STREET SPORTS BAR  
 2101 MILAM STREET  
 COLUMBUS, TEXAS 78934

Project No. 21094  
 Drawn JD  
 Checked BS

AS BUILT

Sheet No. A1.0