



ARCHITECTURE \ INTERIORS \ ENGINEERING


KKT ARCHITECTS, INC.  
2200 SOUTH UTICA PLACE, SUITE 200  
TULSA, OKLAHOMA 74114  
[P] 918.744.4270 \ [F] 918.744.7849  
WWW.KKTARCHITECTS.COM  
C O F A # 534 6/30/21

SUITE 100

SUITE 1170  
VACANT  
1458 RSF

SUITE 1180

SUITE 1190

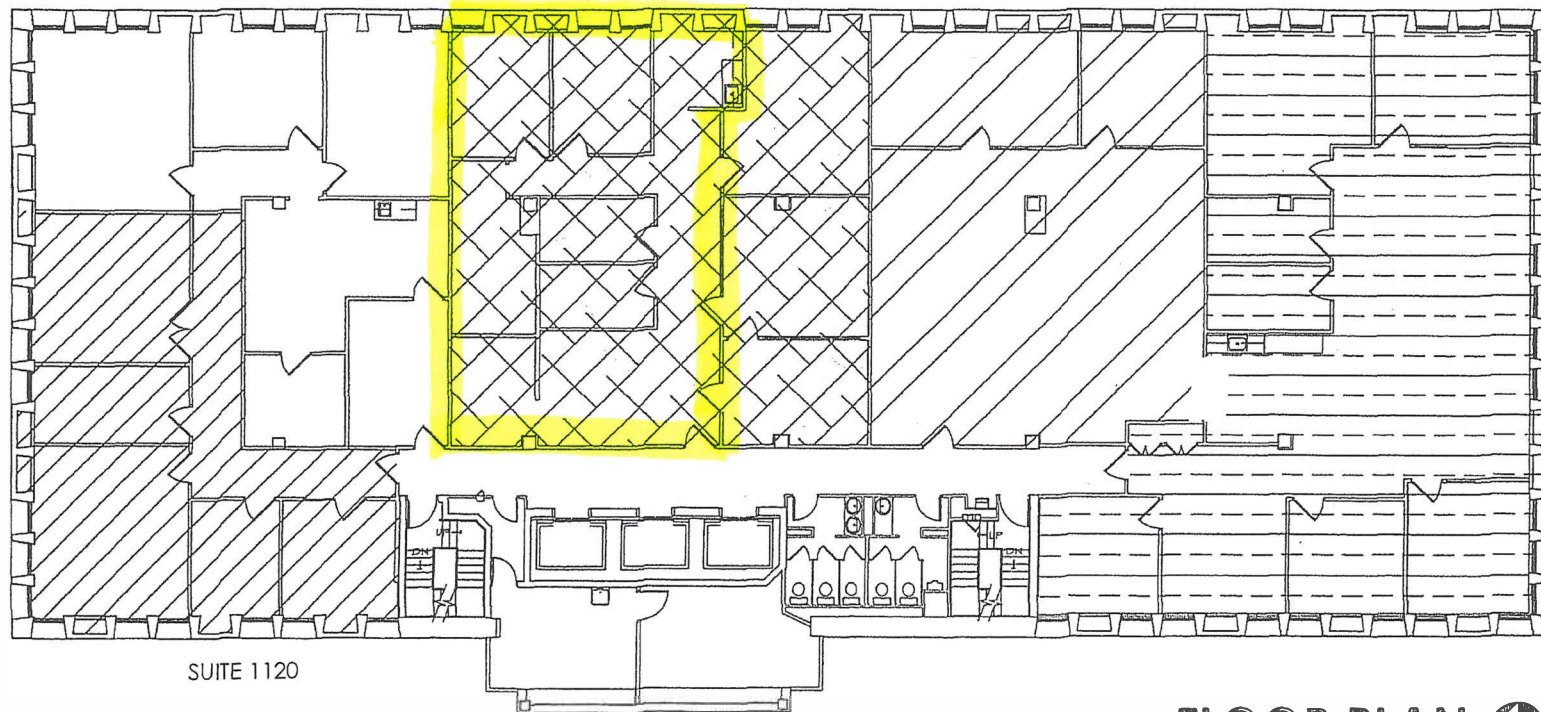

SUITE 1120

**A FLOOR PLAN**   
SCALE: N.T.S. NORTH

**11TH  
FLOOR**

SOUTHLAND  
TOWER  
11TH FLOOR

PRICE  
EDWARDS  
AND COMPANY

03.05.2021



AS-BUILT  
PLAN  
**AS.11**