




1 EAST ELEVATION (FOR REFERENCE ONLY)  
 SCALE: 1/8" = 1'-0" PREVIOUS PERMIT # T105-0086

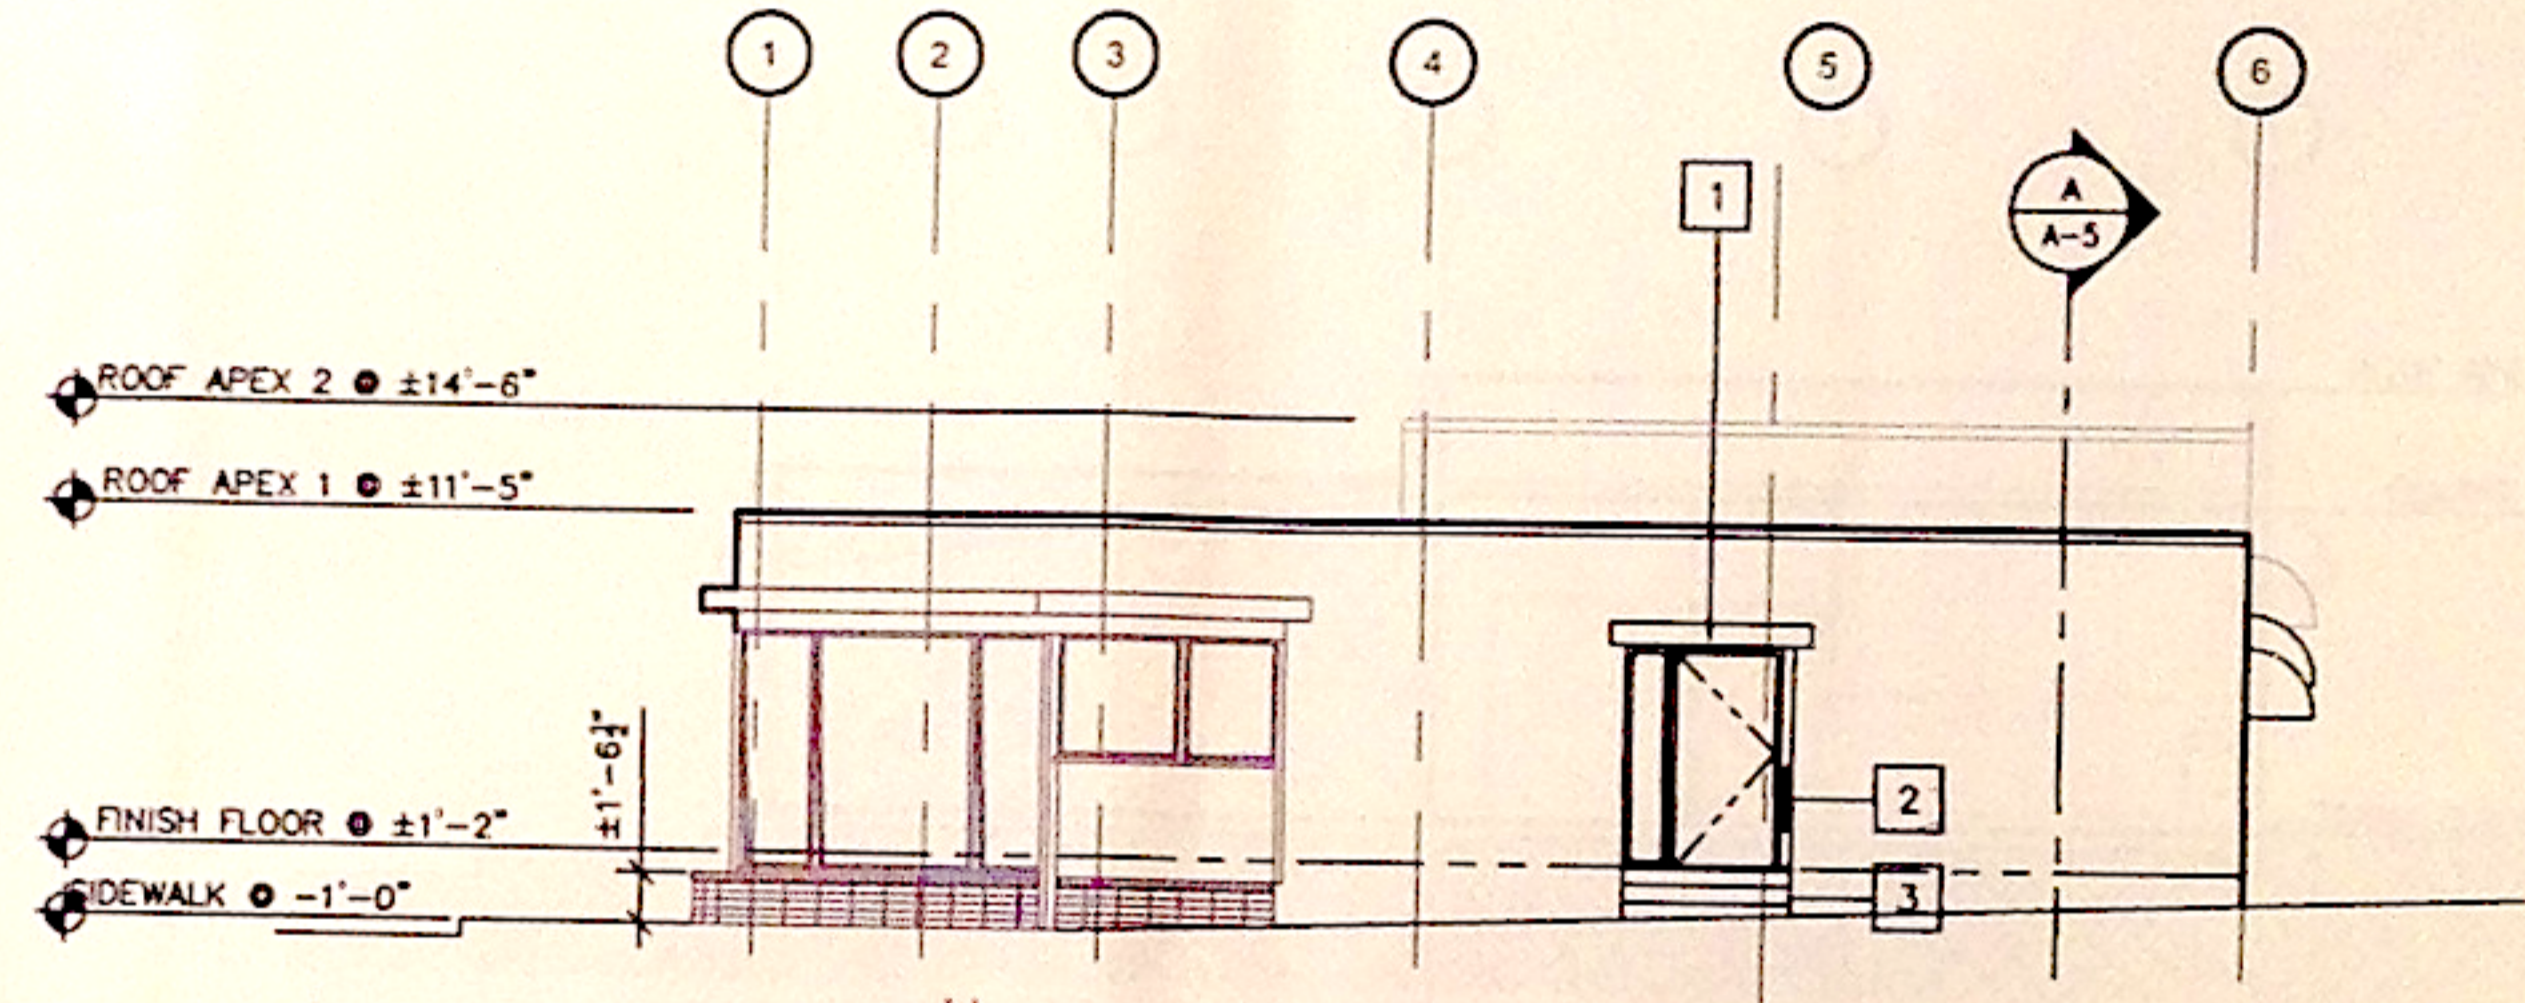

*NORTH*  
~~SOUTH~~ ELEVATION  
 SCALE: 1/8" = 1'-0"

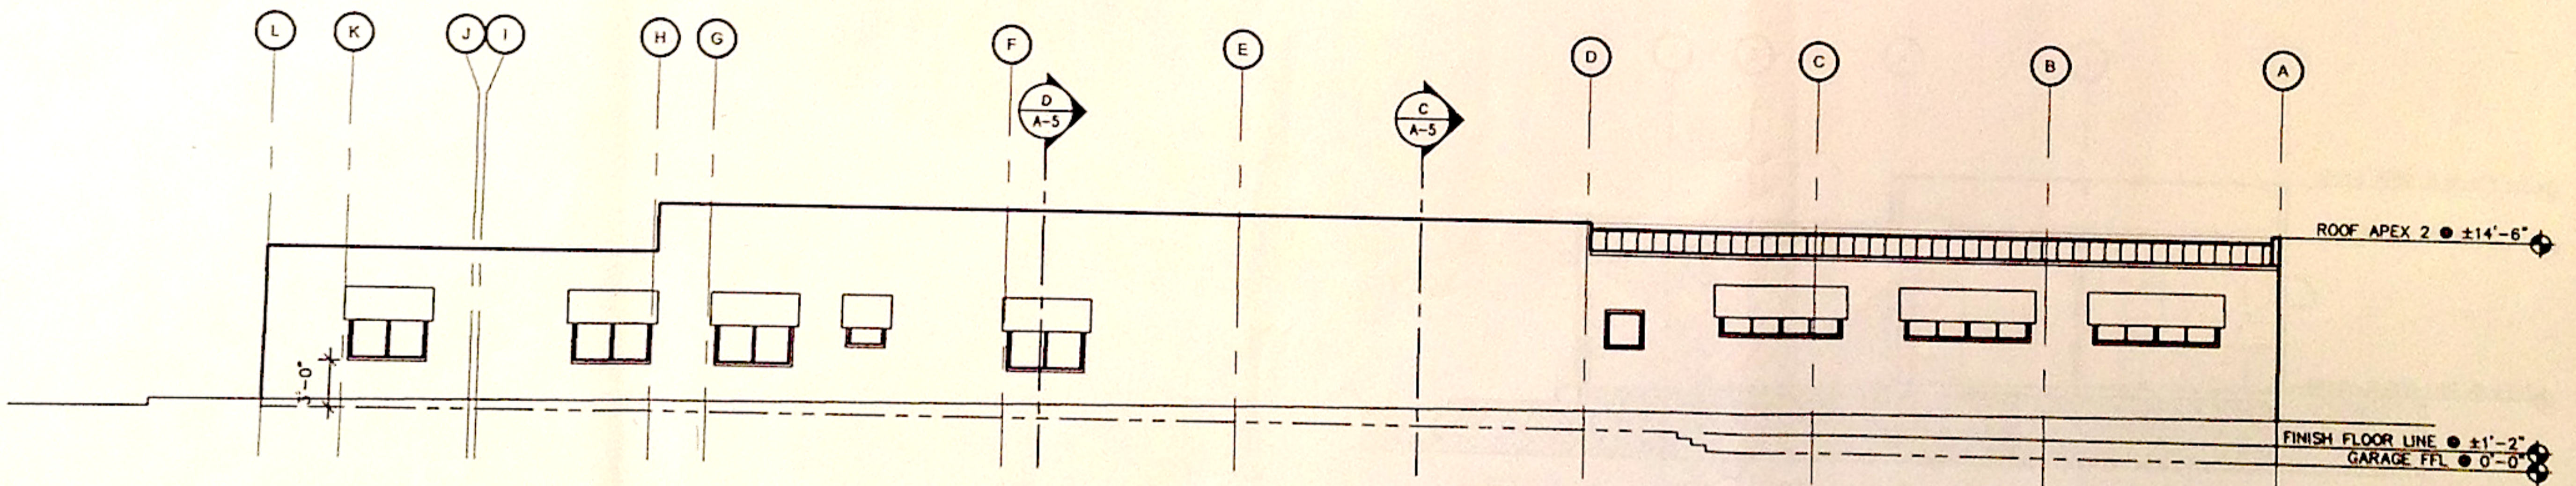

3 WEST ELEVATION (FOR REFERENCE ONLY)  
 SCALE: 1/8" = 1'-0" PREVIOUS PERMIT # T105-0086

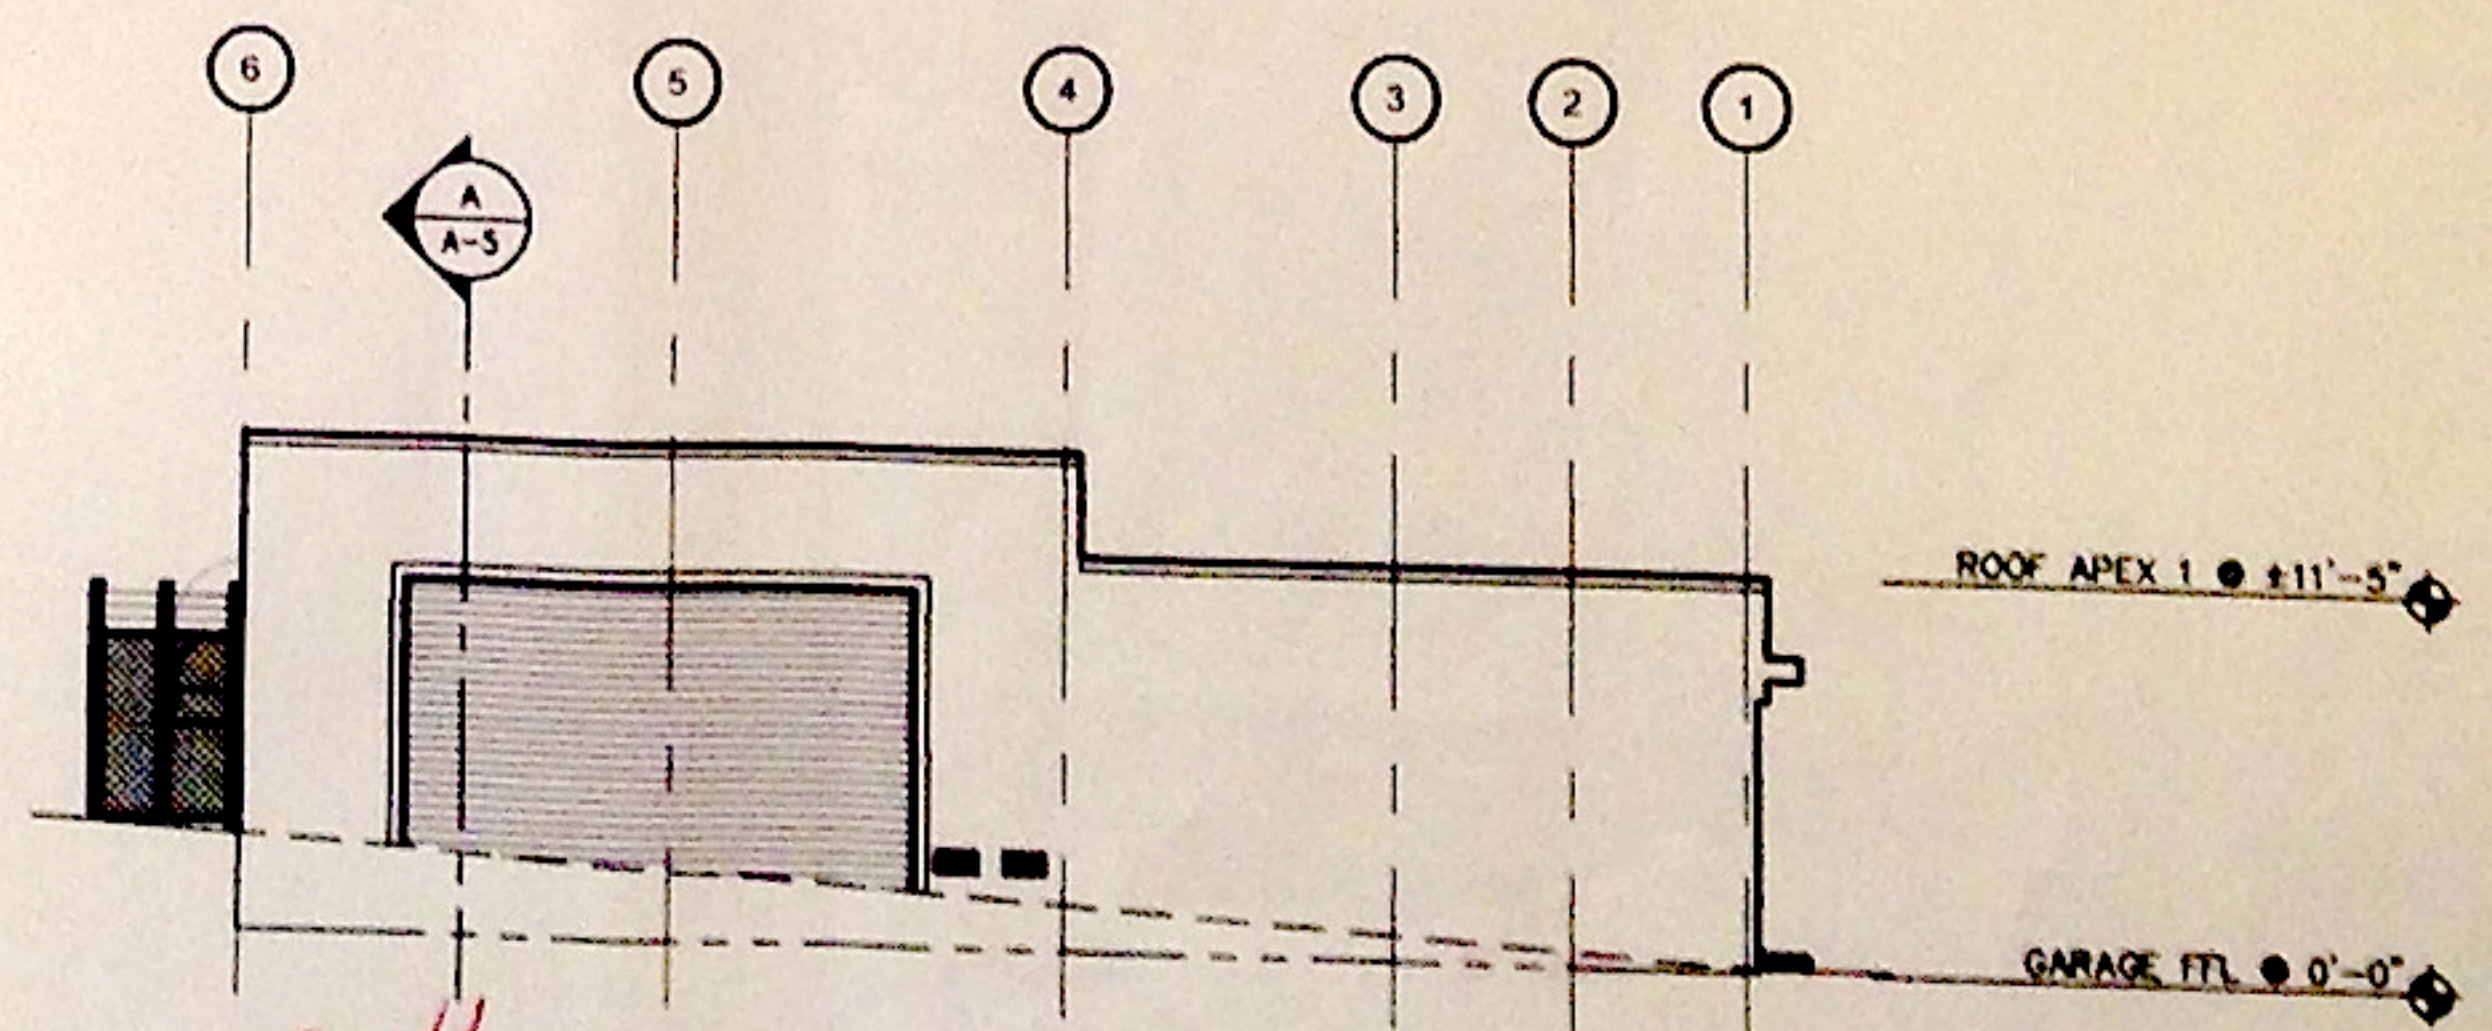

*South*  
~~NORTH~~ ELEVATION (FOR REFERENCE ONLY)  
 SCALE: 1/8" = 1'-0" PREVIOUS PERMIT # T105-0086