


TWO LAKESIDE COMMONS


SUITE 1150

10,589 RSF

AS-BUILT PLAN

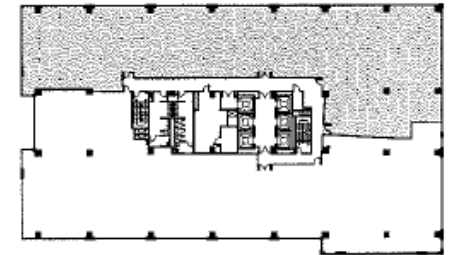

Key Plan

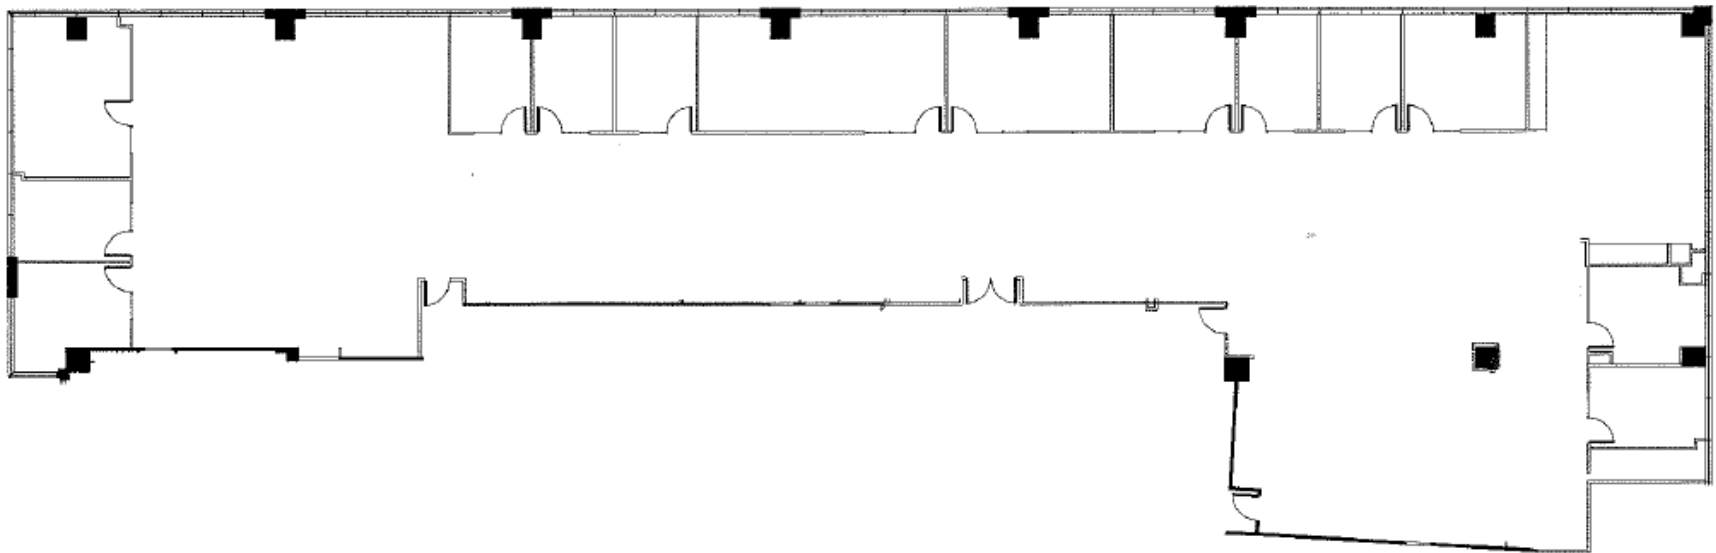

INTERCONTINENTAL
REAL ESTATE CORPORATION

NEWMARK

Two Lakeside Commons, 980 Hammond Drive, Atlanta, GA 30328

Tom Miller, Executive Managing Director | tom.miller@nmrk.com | 770.552.2411