


03/02/26

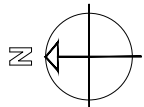

315 & 327 Messner Drive
Wheeling, IL 60090

As-Built

Suite 327

