






LASALLE PLAZA

Minneapolis, Minnesota

SUITE 2200 - SUITE AS-BUILT PLAN (11,982 RSF)

3/64" = 1'-0"

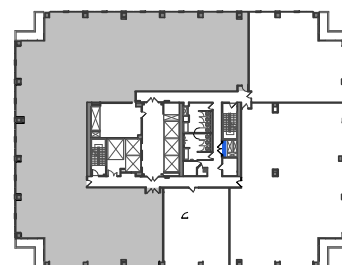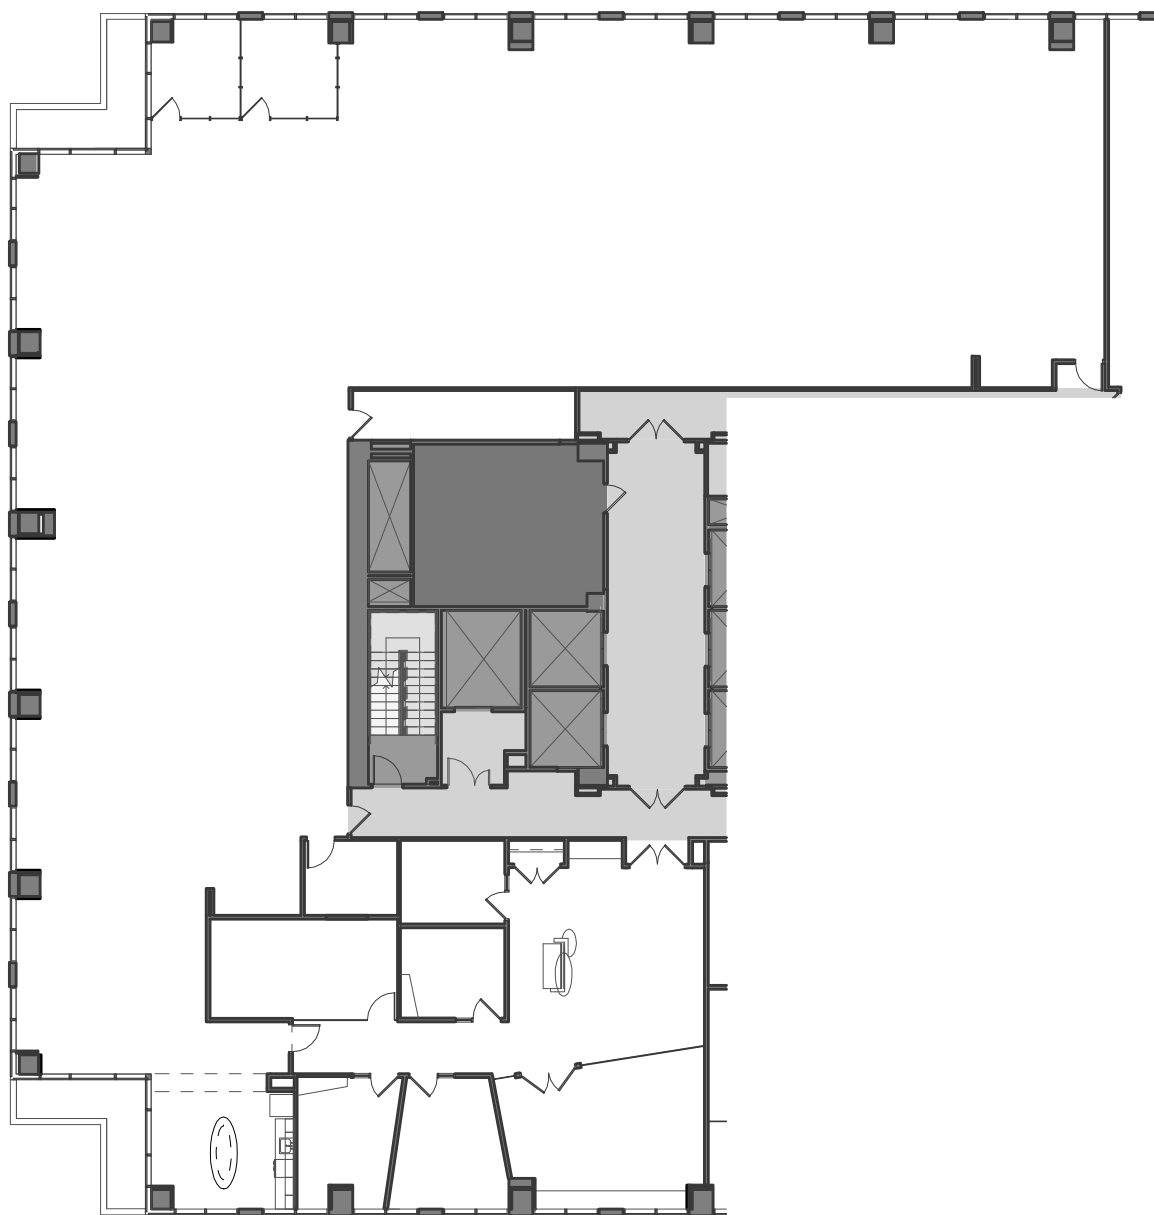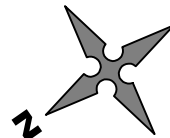

FLOOR 22

For Information, Contact:

Brent Jacobson: 612-355-2609

Ben Krsnak: 612-355-2608

Brandon Otting: 612-355-2620

NELSON

Issue Date: 05/31/2024



HEMPEL
REAL ESTATE