


Property Key

Suite 107 • 108

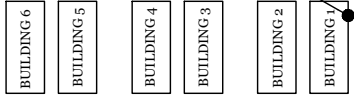


Randolph Business Park As Built Marketing Package

Suite(s) 107 • 108
 1510 Randolph Street
 Carrollton, TX 75006

Sheet **A6**
 Of 30 Sheet(s)

Scale: Not to Scale
 Sheet Size: 11" x 8.5"
 Not For Construction

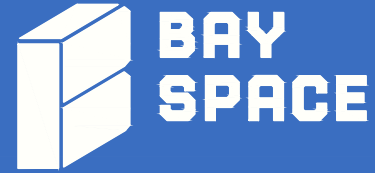


© 2025 HosScans, LLC.
 All right reserved.
 These drawings and any associated documents are protected under U.S. copyright law. No part of this work may be produced, distributed, or used in any form, by any method, for any purpose, without the prior written consent of HosScans, LLC. Unauthorized use is subject to legal action.

Usable Square Foot Analysis

	SQFT	BUILDING PERCENTAGE
OFFICE AREA:	524	26%
WAREHOUSE AREA:	1,455	74%
TOTAL AREA:	1,979	

Building Information

Deck Height:	12'-0"
Clear Height:	10'-0"
Ceiling Height:	8'-0"
Sprinklered:	No
Mechanical Area:	N/A

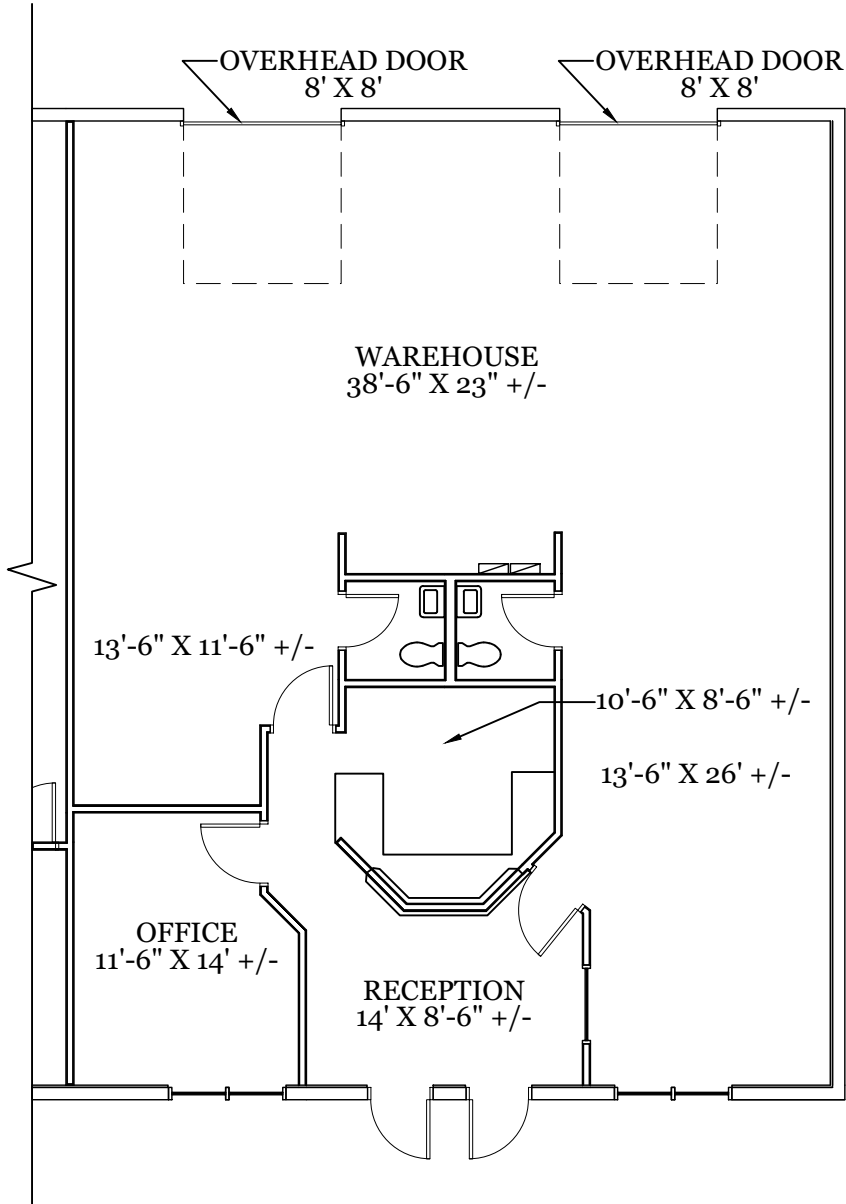

As Built Floor Plan for Marketing

