


Property Key

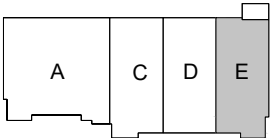

Turtle Creek As Built Marketing Package

4900 - 4914 Creekside Drive, Clearwater, FL 33760

Building: 4902
Suite: E
Sheet: A-4

Scale: Not to Scale
Sheet Size: 8.5" x 11"
Not For Construction




BAY
SPACE

Total Area - 2,084 SF

Building Information

DECK HEIGHT:	13'-10"
CEILING HEIGHT:	8'-10"
CLEAR HEIGHT:	12'-4"
SPRINKLERED:	No
OVERHANG AREA:	81

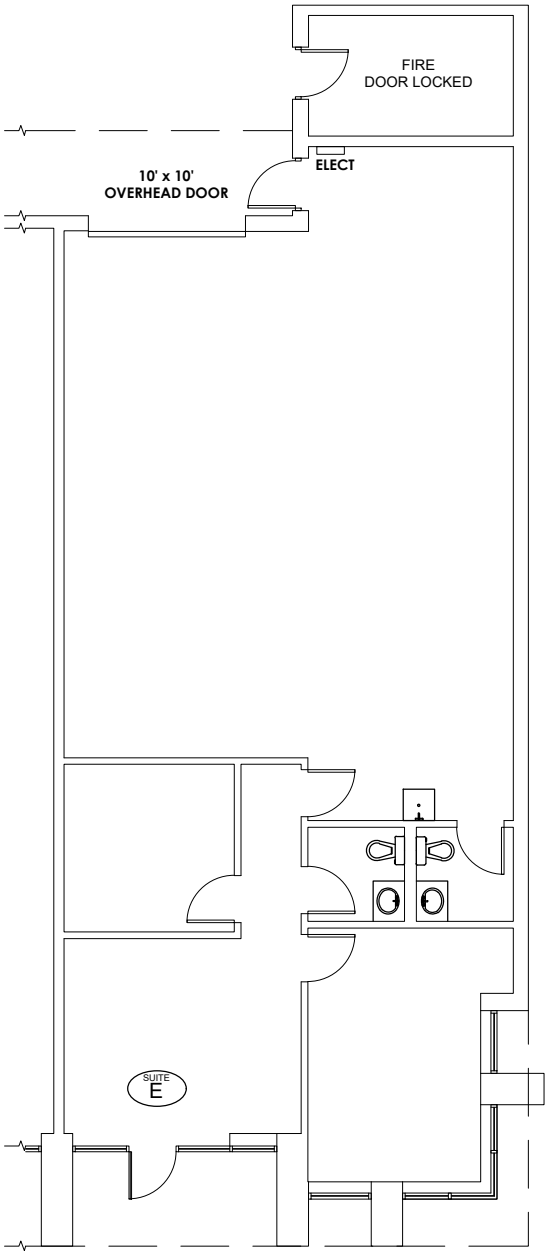

As Built Floor Plan for Marketing

