


# FLOOR PLAN

SCALE: 1" = 20'-0"

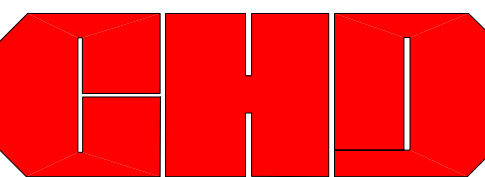

**CUSTOM HOME DESIGNS**

BY

**BILL RASMUSSEN**

3398 AUTUMN RIDGE DRIVE  
CLEVELAND, TN 37312  
BILLRAS53@BELLSOUTH.NET  
423-715-0725

SHEET NO.

**A-1**

AS BUILT PLAN

1700 OVERHEAD BRIDGE ROAD