


# 1000 Jorie Blvd

1000 Jorie Blvd.  
Oak Brook, IL 60523

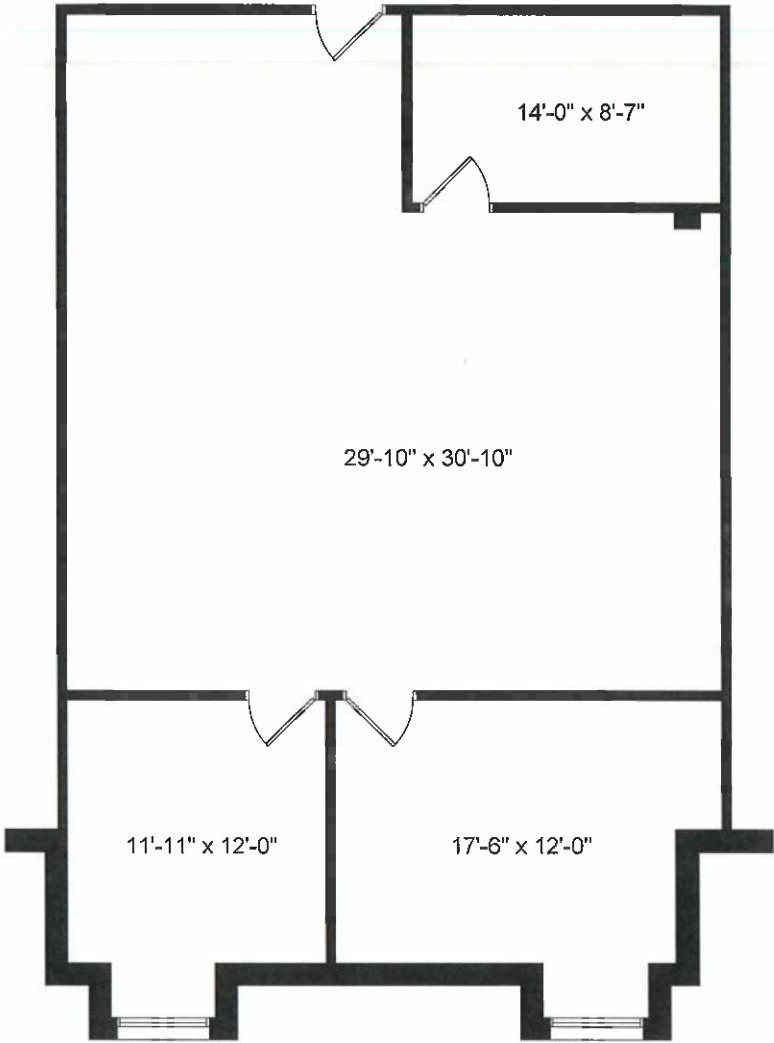

## Suite 365 - "As-Built" Conditions

1,517 Rentable Square Feet

Scale: N.T.S.

