


SITE PLAN

IN ORDER TO PROCESS LAND USE APPLICATIONS, ALL SUBMISSIONS MUST INCLUDE A COMPLETED SITE PLAN MAP OF THE PROPOSED PROJECT (SEE INTRUCTIONS), submission of an incomplete site plan map will be considered as an incomplete application and returned to the applicant:

PROJECT/OWNER NAME: Kandi Bersanti DATE: 5-4-05
PARCEL #(s): 312407000 Lot 3 DRAWING SCALE: 1/4 inch(s) = 70 feet


Bersanti Short Plat

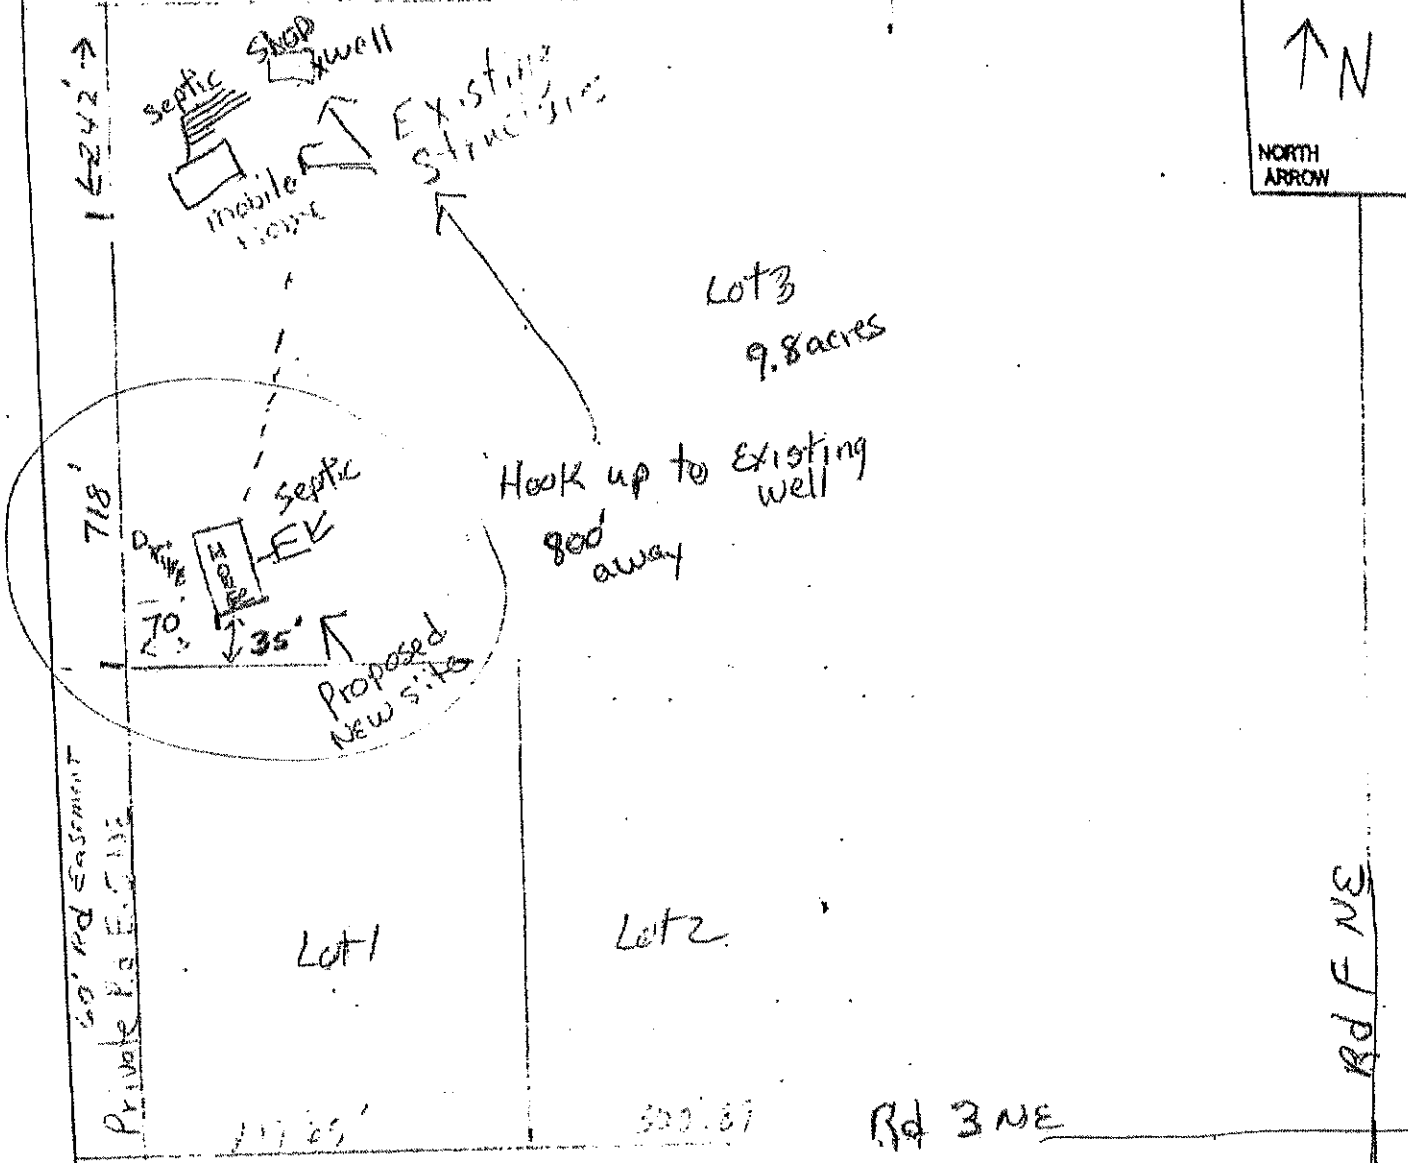

Directions to the Site: _____

Prepare scaled plot plan showing all proposed improvements


As Built
Drawing

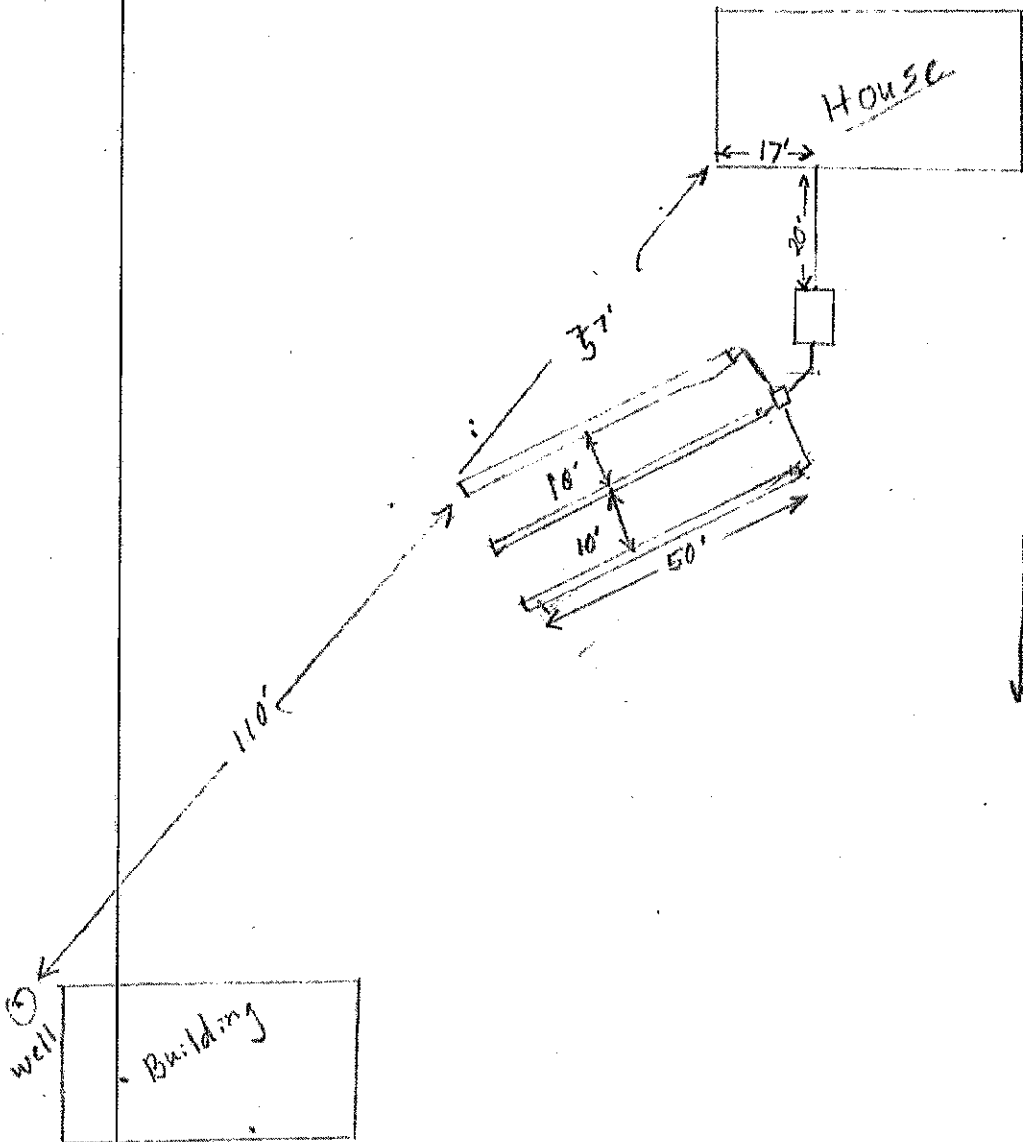

Infiltrator
Chamber Drainfield
by OWNER
Apr 14, 2003
JRC

Drainfield Size in square feet _____
Septic Tank size _____

Scale _____

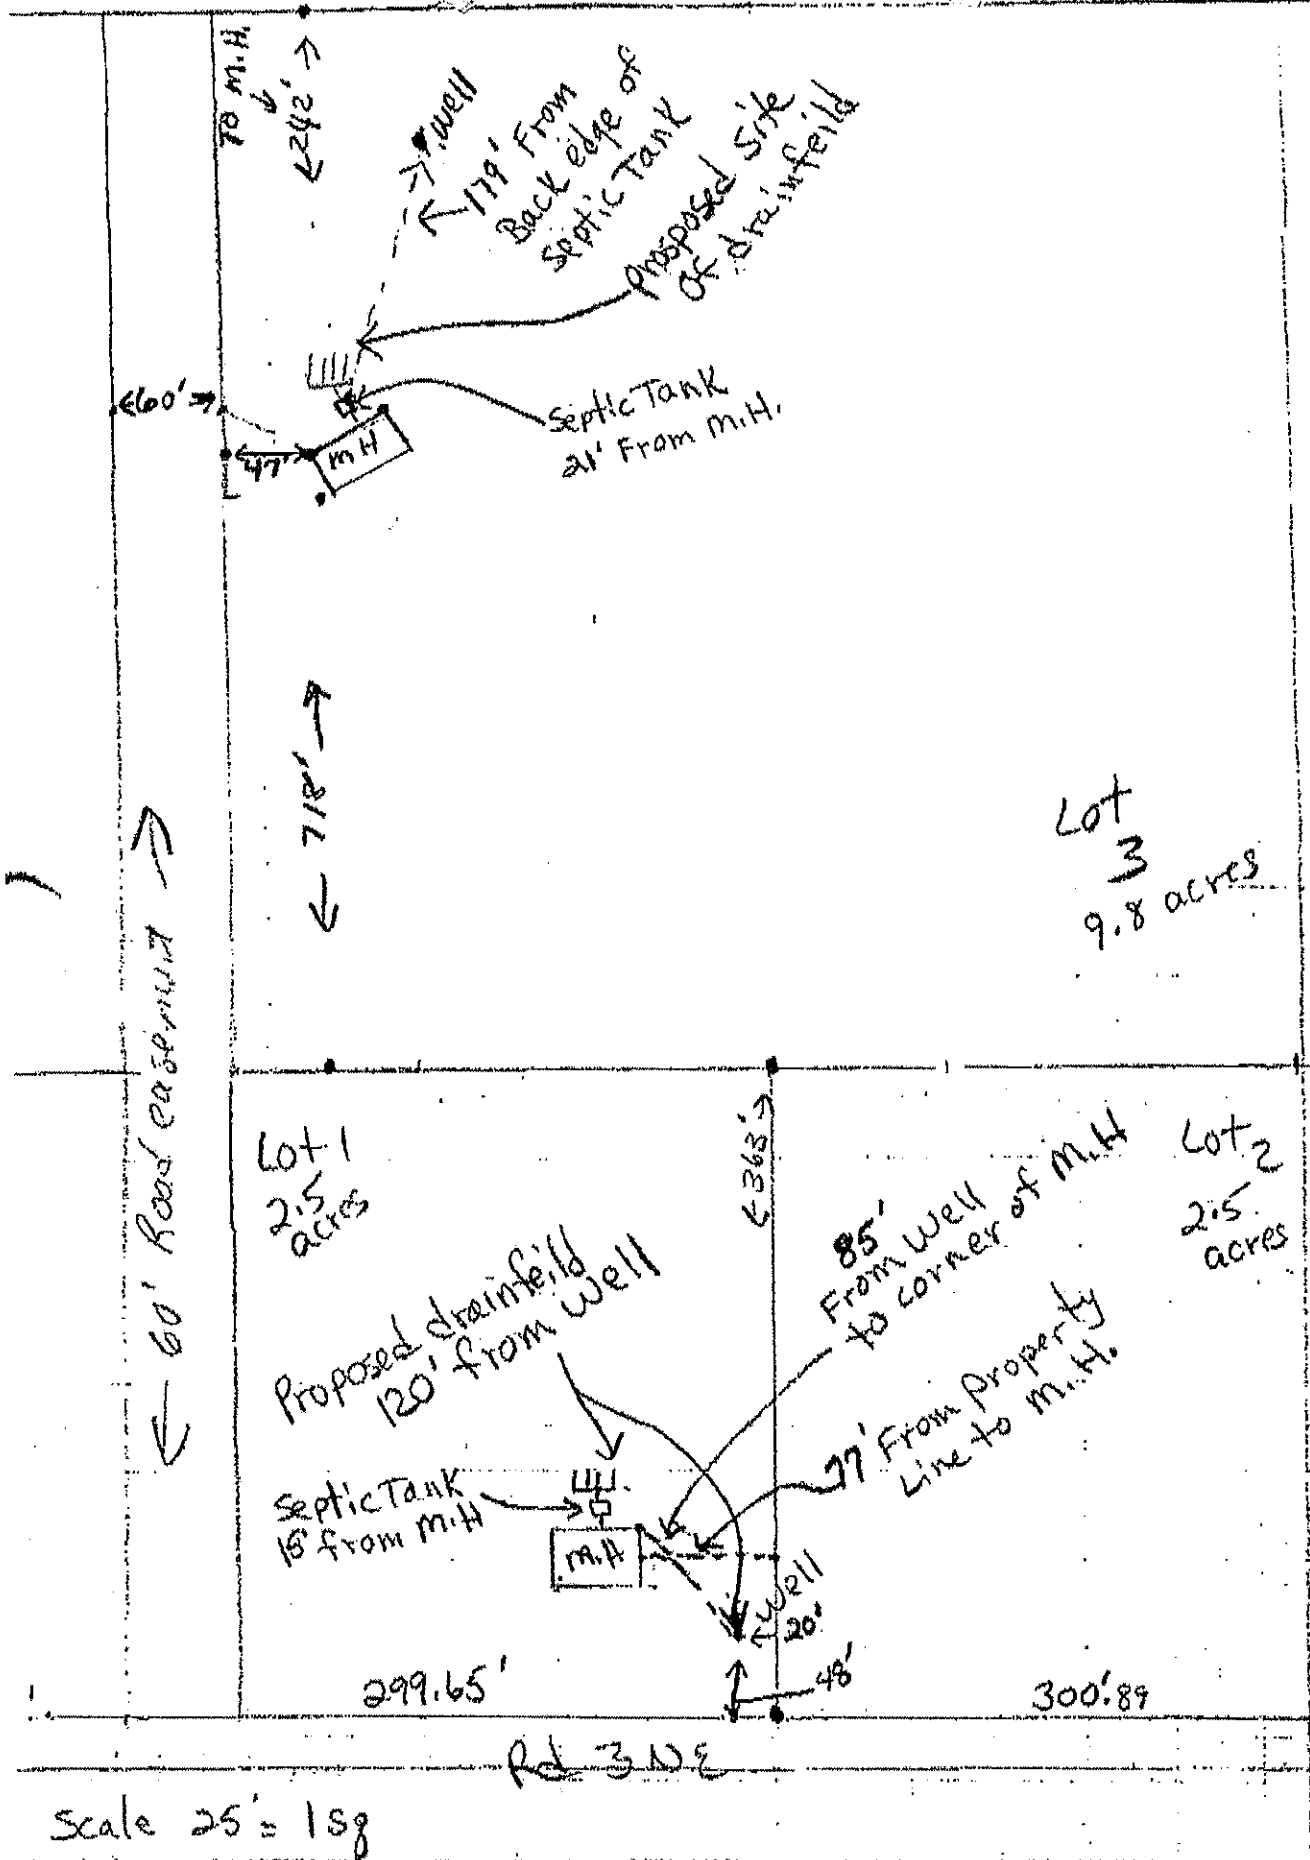

Bersanti Sheet Plat

Lot 3
9.8 acres

Lot 1
2.5 acres

Lot 2
2.5 acres

Scale 25' = 1"sg