





LASALLE PLAZA

Minneapolis, Minnesota

SUITE 0125 - SUITE AS-BUILT PLAN (15,335 RSF)

3/64" = 1'-0"

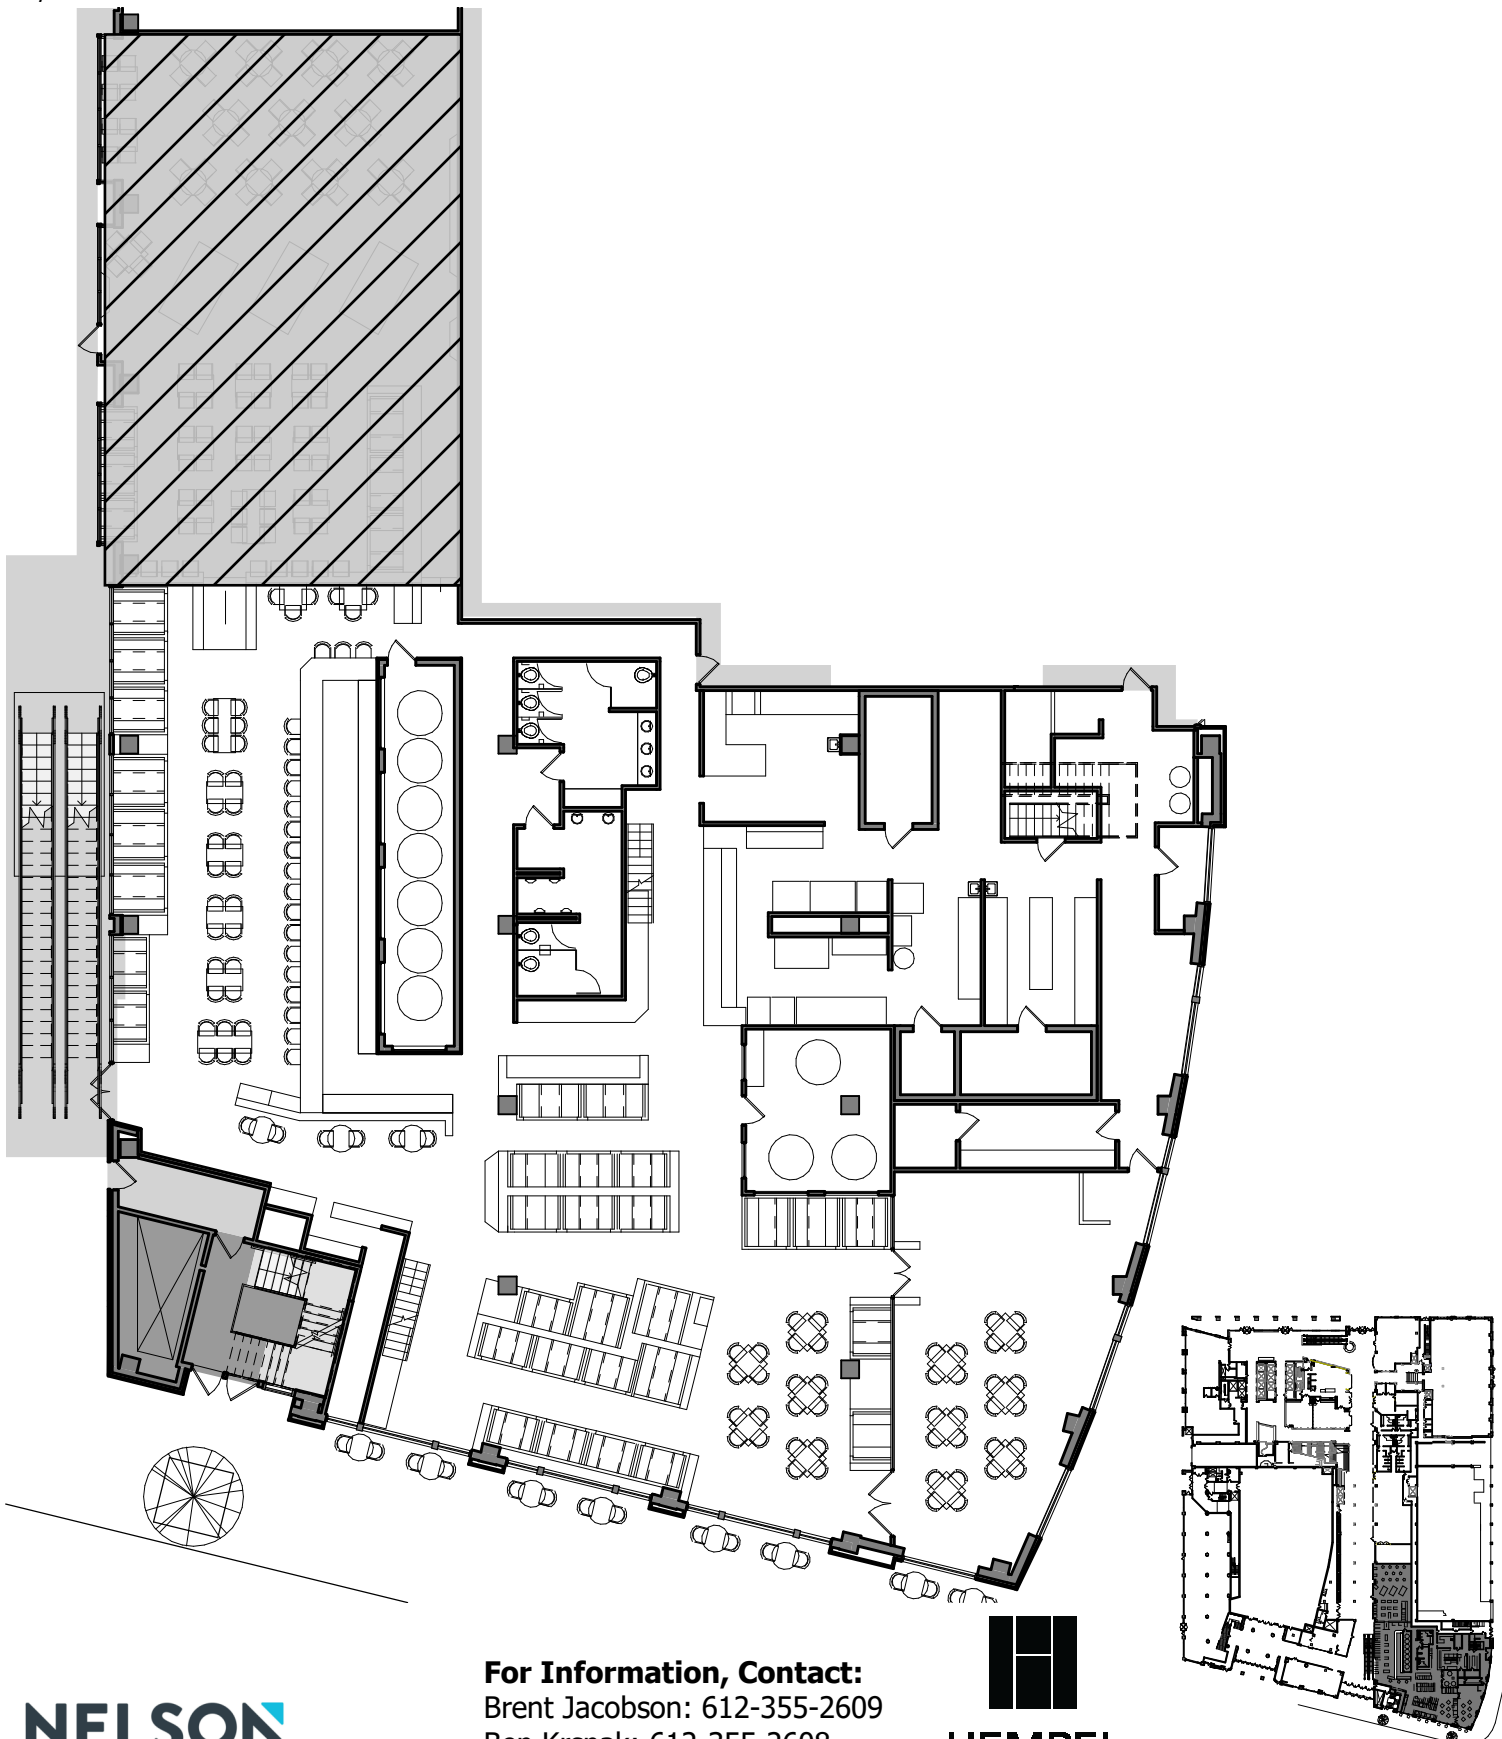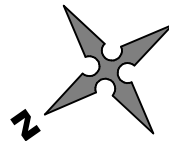

NELSON
Issue Date: 09/05/2023

For Information, Contact:
Brent Jacobson: 612-355-2609
Ben Krsnak: 612-355-2608
Julie Yeazle: 612-817-6315



FLOOR 1