


SHEET TITLE
EXISTING FLOORPLAN

PREPARED FOR DNCRE
 ATTN: DELL NICHOLS
 1353 N 1075 W, STE 6
 FARMINGTON, UT 84025

LOCATION 1630 S INDUSTRIAL RD, SLC, UT

| REV | DATE | DESCRIPTION |
|-----|------|-------------|
| 1 | | |
| 2 | | |
| 3 | | |
| 4 | | |
| 5 | | |

| | |
|----------|------------|
| DATE: | 03/29/2024 |
| SCALE: | NTS |
| DRAWN: | MLW |
| CHECKED: | MLW |

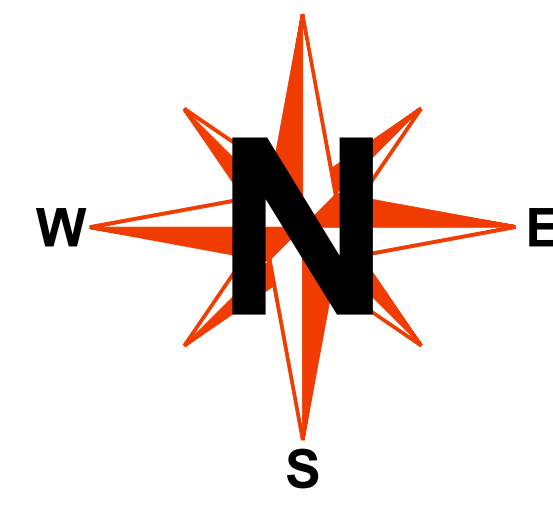

UTAH LAND SURVEYING, LLC
 A PROFESSIONAL LICENSED LAND SURVEYING COMPANY

1359 FAIRWAY CIR
 FARMINGTON, UT 84025

PHONE 801.725.8395
 mikew@utahlandsurveying.com

www.utahlandsurveying.com

JOB NUMBER
2084-24

SHEET
1 OF 1