


2,050 RSF

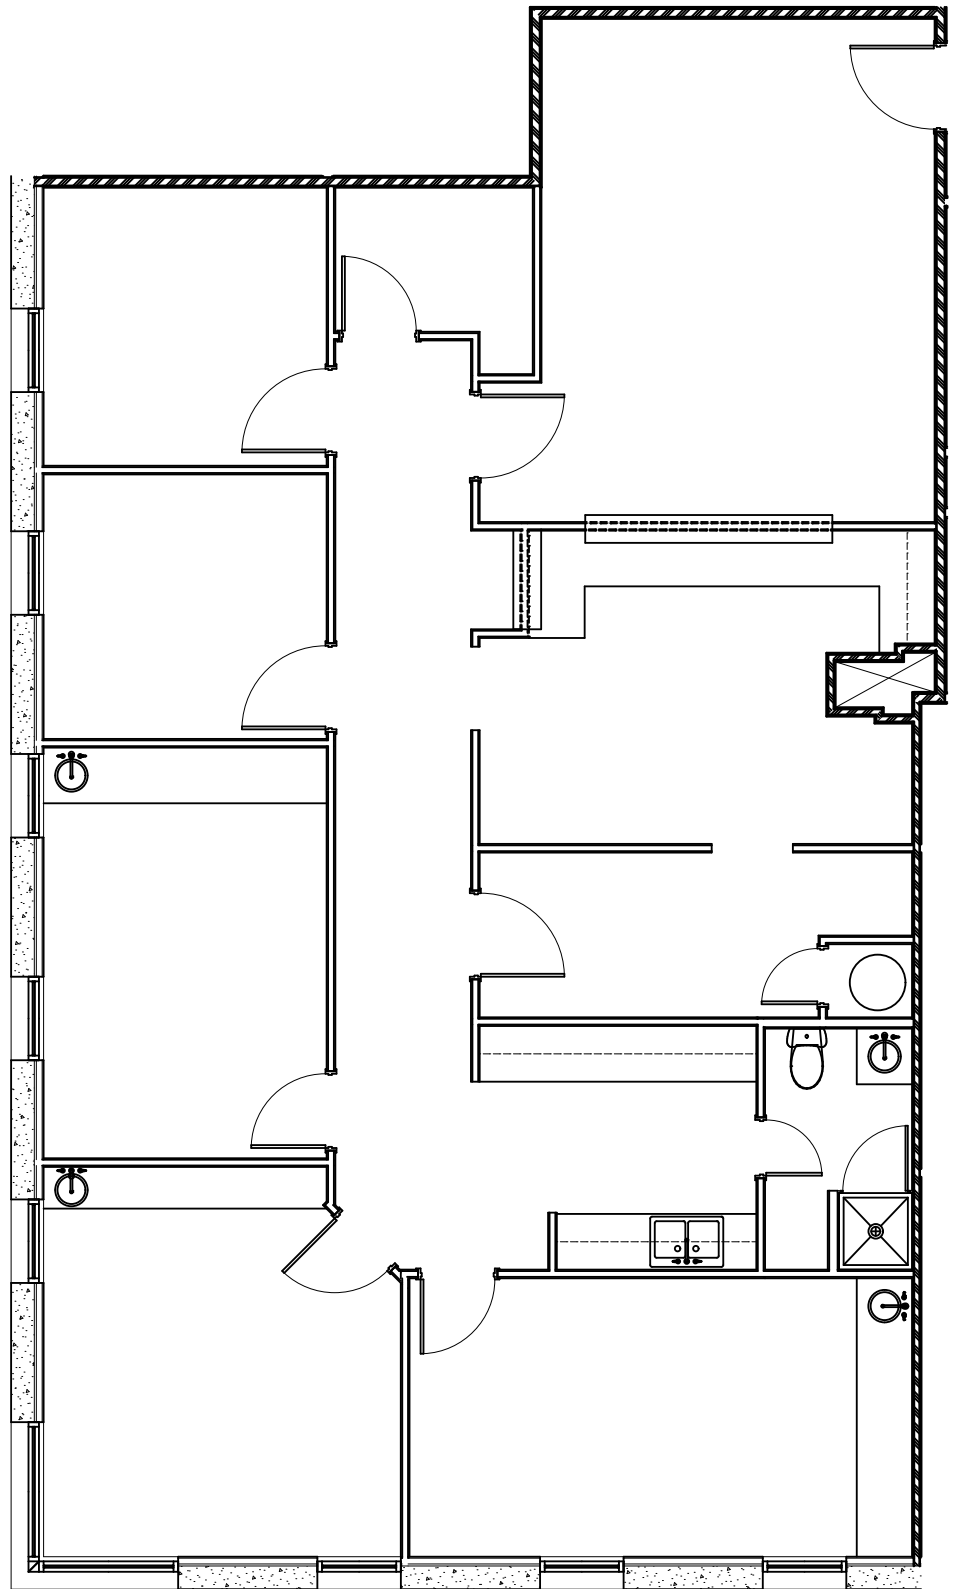

Date 04/29/15

Project No. 58-1808

Drawing

202

AS BUILT LEASING PLANS FOR:
**GREENWOOD MEDICAL
CENTER**

7180 EAST ORCHARD ROAD
CENTENNIAL, COLORADO 80111

