


1 *Reduced As-built*
Suite 901

Scale: 1/8" = 1'-0"

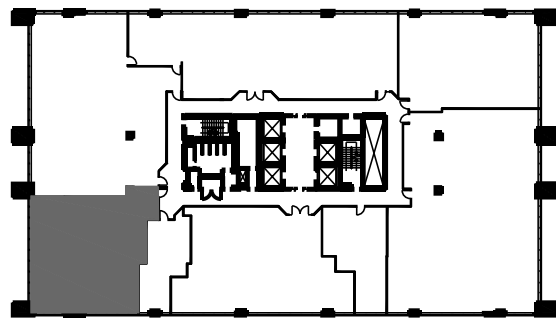

Proximity Plan

Suite 901
The Chancery
2,362 RSF