


SUITE 114
AS BUILT - 1 OF 1
8510 MCALPINE PARK DRIVE, CHARLOTTE, NC
4,805 RSF
NOT TO SCALE
DATE: SEPTEMBER 12, 2023

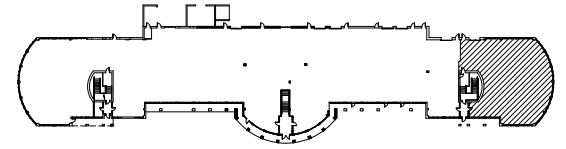

KEY PLAN

