

**ROYAL OAK
PROFESSIONAL
PLAZA**


Floor 02

Suite 201

AS-BUILT

5,234 SF

AVAILABLE

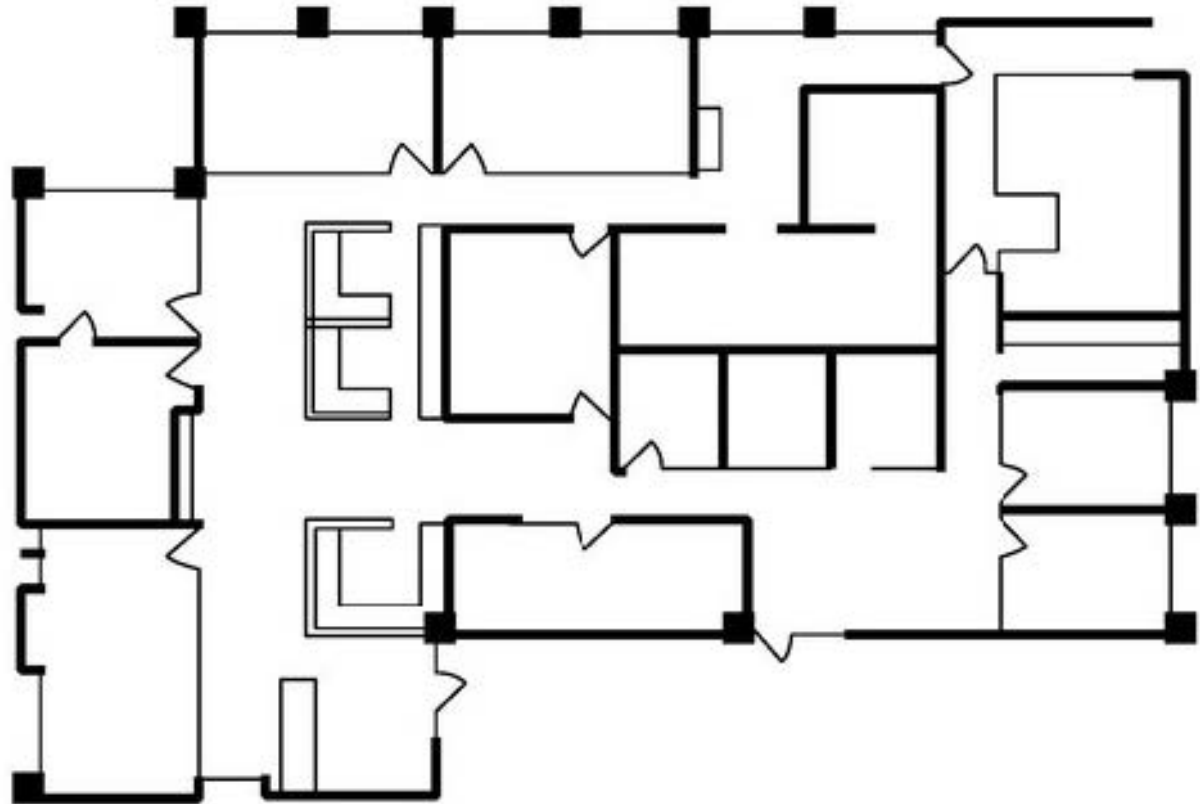

RACHAEL THOMPSON
Senior Vice President
602.513.5122
rachael.thompson@kidder.com

PERRY GABUZZI, CCIM
Senior Vice President
602.513.5116
perry.gabuzzi@kidder.com