


SUITE 205
AS BUILT - 1 OF 1
8510 MCALPINE PARK DRIVE, CHARLOTTE, NC
1,925 RSF
SCALE: 1/8" = 1'-0"
DATE: AUGUST 6, 2021

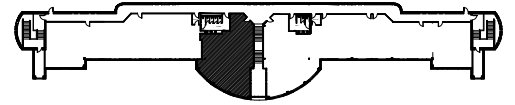

KEY PLAN

