



Availabilities


1840 S Stapley Dr

As Built

Suite 102

RSF

5,512

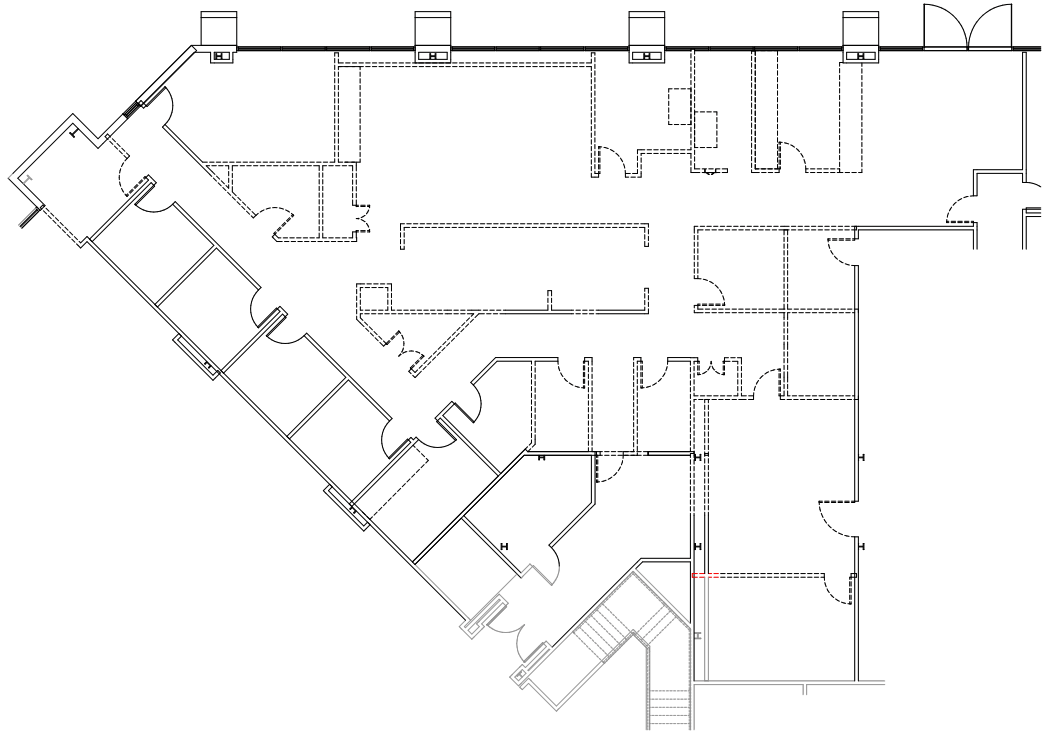

For leasing information contact

Rachael Thompson

602.513.5122

rachael.thompson@kidder.com

Perry Gabuzzi, CCIM

602.513.5116

perry.gabuzzi@kidder.com

stapleymedicalcenter.com



Harbert
Management
Corporation

CYPRESS
OFFICE PROPERTIES



Kidder
Mathews

This information supplied herein is from sources we deem reliable. It is provided without any representation, warranty or guarantee, expressed or implied as to its accuracy. Prospective Buyer or Tenant should conduct an independent investigation and verification of all matters deemed to be material, including, but not limited to, statements of income and expenses. Consult your attorney, accountant, or other professional advisor.