


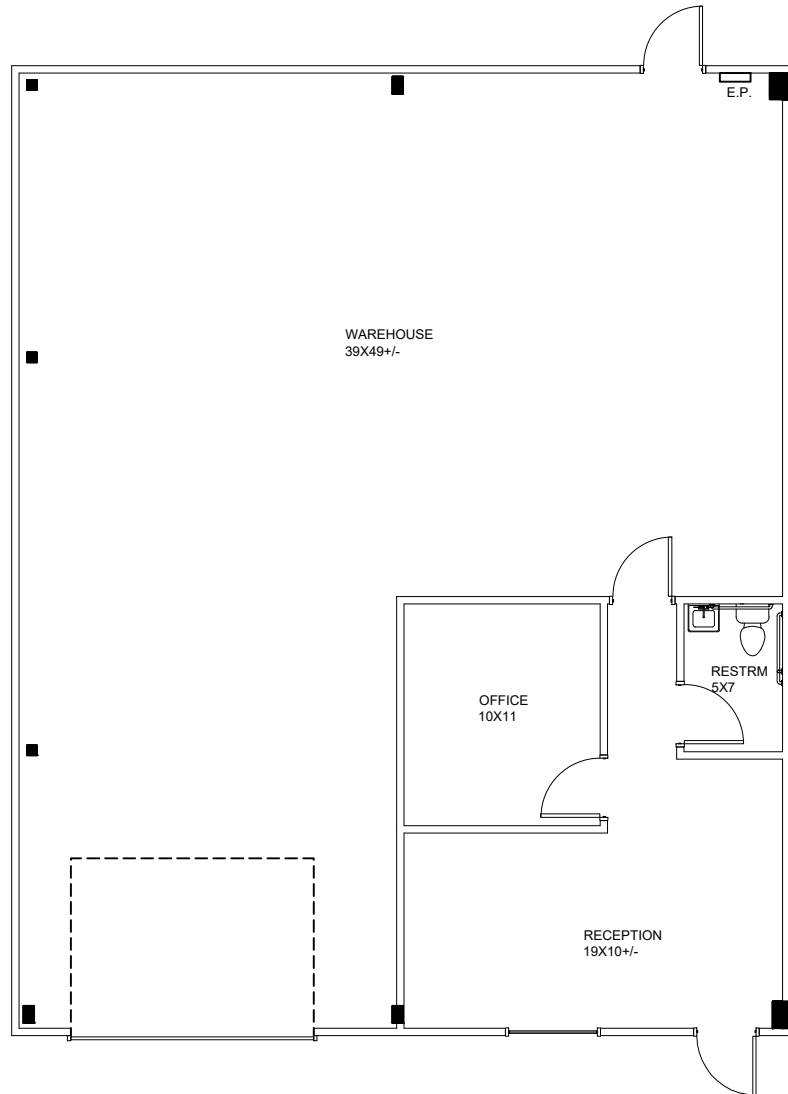

SUITE B-1--2,000 RSF

SCALE: N.T.S.

SUITE B1

AS-BUILT PLAN

6820 MEADOWRIDGE COURT
ALPHARETTA, GA 30005

6.12.25

