233 CARDINAL MEDEIROS AVENUE CONDOMINIUM
233 CARDINAL MEDEIROS AVENUE CAMBRIDGE, MASSACHUSETTS

PLAN SCALE IS 1/4" = 1'-0"
DRAWN BY TIMOTHY BURKE ARCHITECTURE INC,
142 BERKELEY STREET,
BOSTON, MASSACHUSETTS
NOVEMBER 30, 2006

GRAPHIC SCALE

I HEREBY CERTIFY THAT THIS PLAN WAS PREPARED IN ACCORDANCE WITH THE RULES AND REGULATIONS OF THE REGISTERS OF DEEDS OF THE COMMONWEALTH OF MASSACHUSETTS.

DATE 12-4-06 SIGNED

I HEREBY CERTIFY THAT THIS PLAN SHOWS UNITS #1, #2, #3, #4, AND #5 OF 233 CARDINAL MEDEIROS AVENUE CONDOMINIUM, AND I FURTHER CERTIFY THAT THE PLANS FULLY AND ACCURATELY DEPICT THE LAYOUT, LOCATION, UNIT NUMBER, AND DIMENSIONS OF THE UNITS AS BUILT.

DATE 12-4-06 SIGNED

NOTES:

1. ALL AREAS SHOWN ARE APPROXIMATE AREAS.
2. ALL STRUCTURAL WALLS ARE COMMON AREAS.
3. ALL MEASUREMENTS ARE TO FINISHED SURFACES OF WALLS.
4. THE BUILDING HAS NO NAME.

LEGEND AND ABBREVIATIONS:

UNIT SEPARATION — WINDOW
PROPERTY LINE — RESIDENTIAL COMMON AREAS
UNIT ENTRANCE — LIMITED RESIDENTIAL COMMON AREA
DIMENSION LINE — LIMITED COMMERCIAL COMMON AREA

D - DINING ROOM
BR - BED ROOM
LR - LIVING ROOM
CL - CLOSET
B - BATH ROOM
S - STAIR
K - KITCHEN

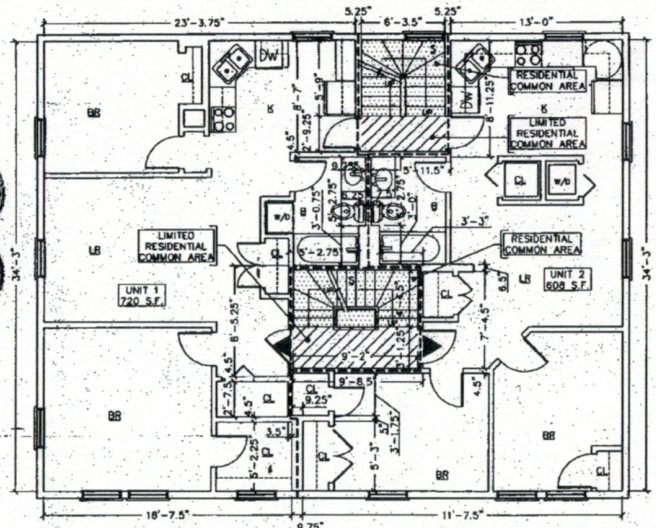

Second Floor Plan

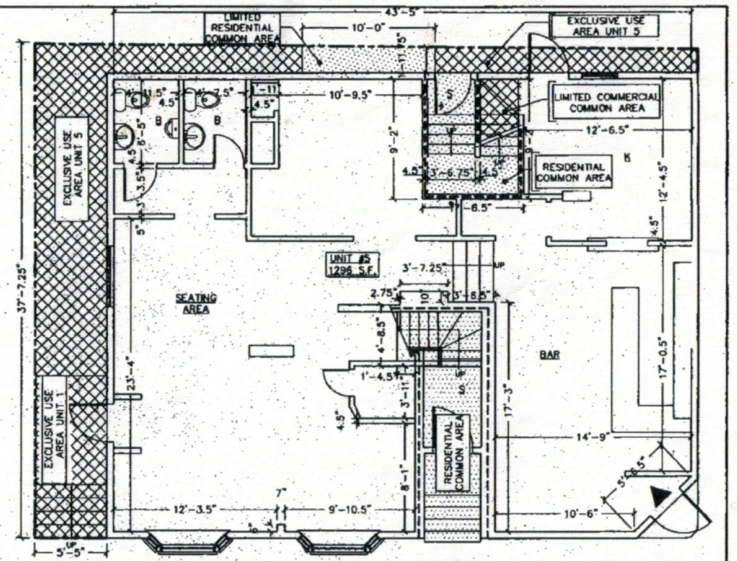

First Floor Plan

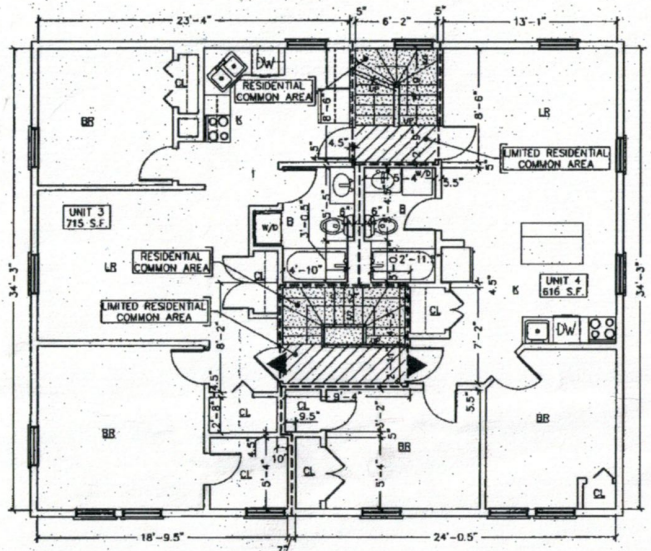

Third Floor Plan

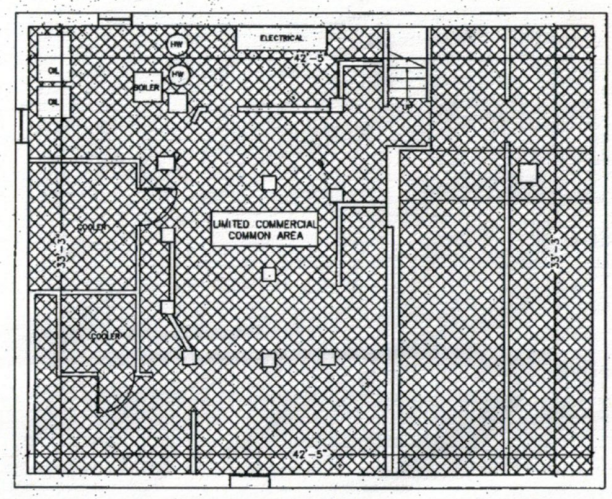

Basement

Middlesex Registry of Deeds,
Southern District
Cambridge, Massachusetts
Plan No. 68 of 2007
Rec'd 1-18 2007
at 2:24 P.M.
Attest: Eugene C. Rowe
Register

Pl # 68 1-18-2007 2:24 P.M.

68