5422 W THUNDERBIRD ROAD, GLENDALE, AZ 85306

THUNDERBIRD MEDICAL PLAZA I

Floor 01

Suite 21/22
AS-BUILT

1,545 SF
AVAILABLE

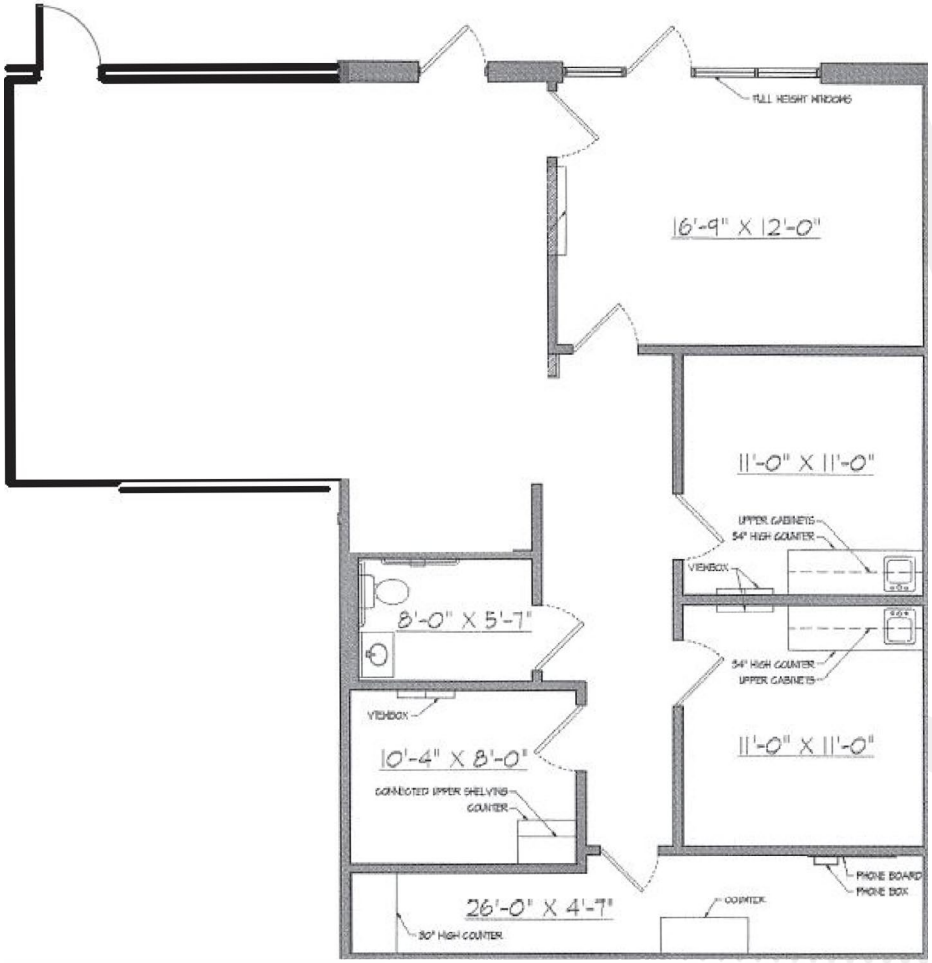

RACHAEL THOMPSON
Senior Vice President
602.513.5122
rachael.thompson@kidder.com

PERRY GABUZZI, CCIM
Executive Vice President
602.513.5116
perry.gabuzzi@kidder.com

View Portfolio

Kidder Mathews