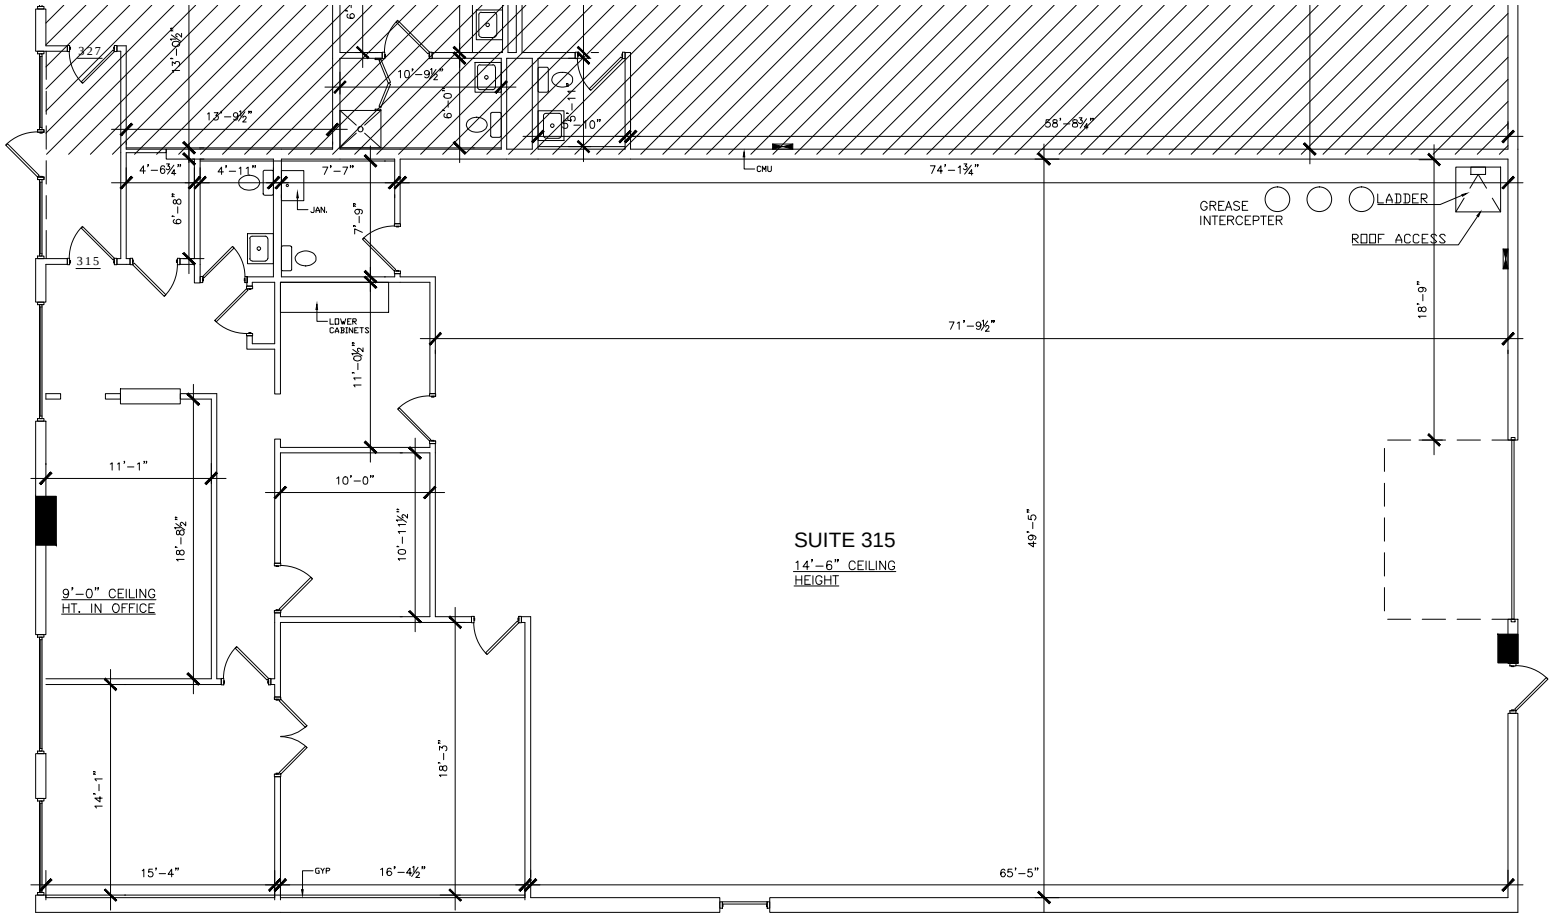

03/02/26

N

315 & 327 Messner Drive
Wheeling, IL 60090

As-Built

Suite 315

DD MR PLANNING