RENTAL SPACE LAYOUT

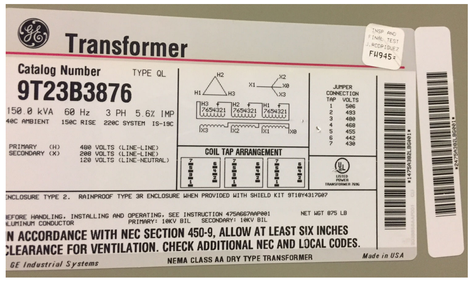

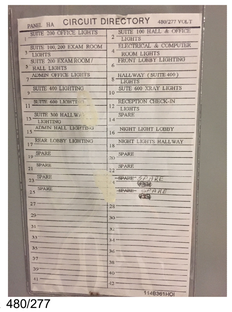

PANEL HA 480/277

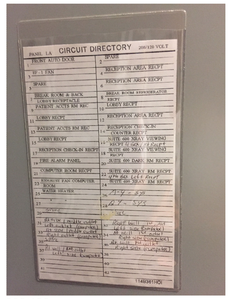

PANEL LA 208/120

PANEL HB 480/277

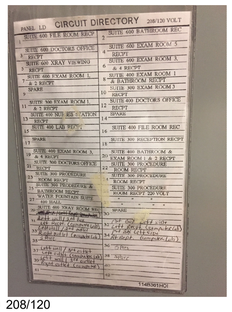

PANEL LD 208/120

PANEL HC 480/277

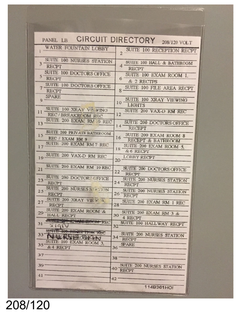

PANEL LB 208/120

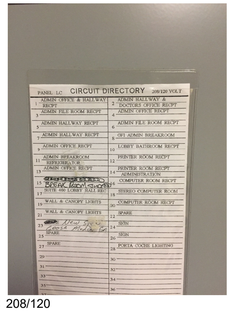

PANEL LC 208/120

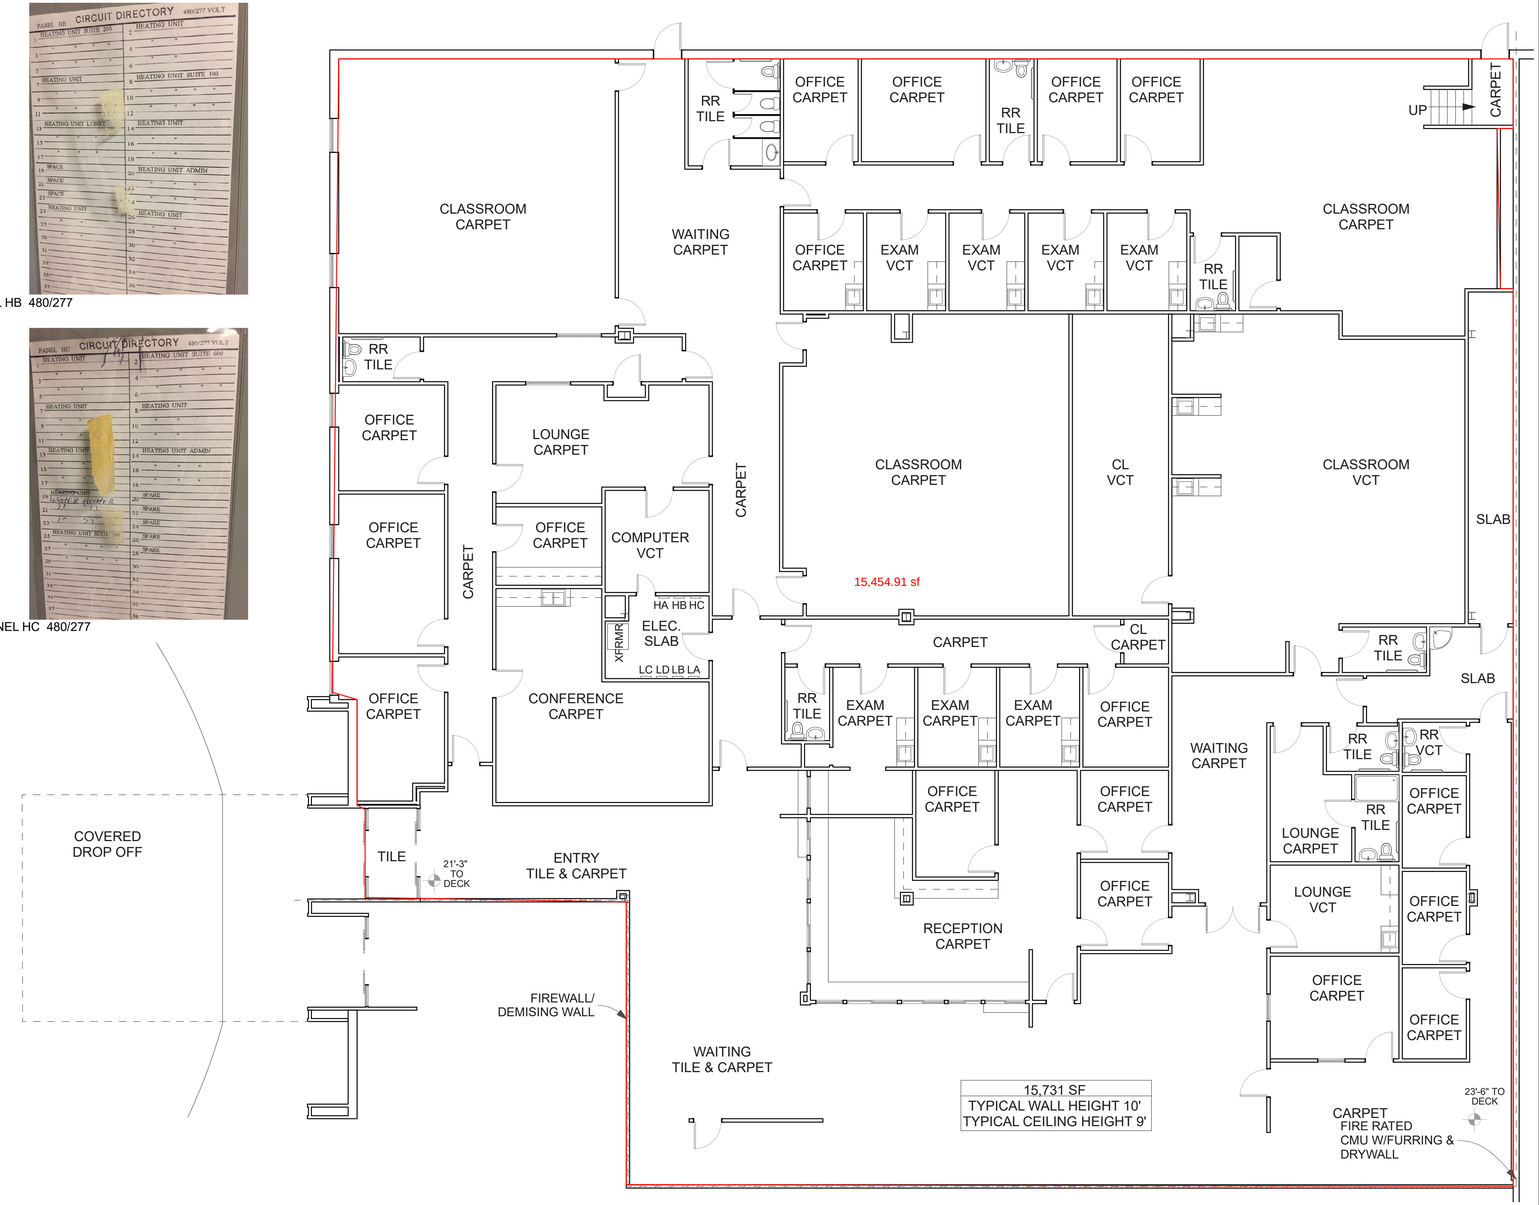

1 EXISTING FLOOR PLAN
SCALE: 1/8" = 1'-0"
0 4' 8' 16'

ELIZABETH DUNAY DESIGN
366 PLAINVILLE RD NE
ROME, GEORGIA 30161
ph_706 766-0366
beth@edunaydesign.com

RENTAL SPACE LAYOUT
RH LEDBETTER PROPERTIES
14 RIVERBEND DRIVE
ROME, GA 30161

EXISTING PLAN

PROJECT # 1815
DATE:
<DATEOFISSUE>
STATUS: SD

A-1