LEGEND

- EXIT — ILLUMINATED EXIT SIGN WITH REMOTE HEADS
- EMERGENCY REMOTE LIGHT UNIT (R.E.L - REMOTE EXTERIOR LIGHT, R.I.L - REMOTE INTERIOR LIGHT)
- FE — FIRE EXTINGUISHER WITH MOUNTING BRACKET (5LB ABC, 5 GAL.DRY CHEM.)
- MOST REMOTE POINT OF TRAVEL
- EXIT DOOR REMOTENESS
- PATH OF EGRESS TRAVEL
- 54' T.D. — LENGTH OF EGRESS TRAVEL DISTANCE TO EXIT DOOR
- DOOR CAPACITY 44" / .2 = 220 OCC. — EXIT DOOR CAPACITY VS. OCCUPANCY USE — 11 OCC.
- 113C — DOOR NUMBER
- PREP 113 563 S.F. 9 OCC. — ROOM NAME, ROOM NUMBER, ROOM SQ. FT., # OF OCCUPANCY FOR SPACE

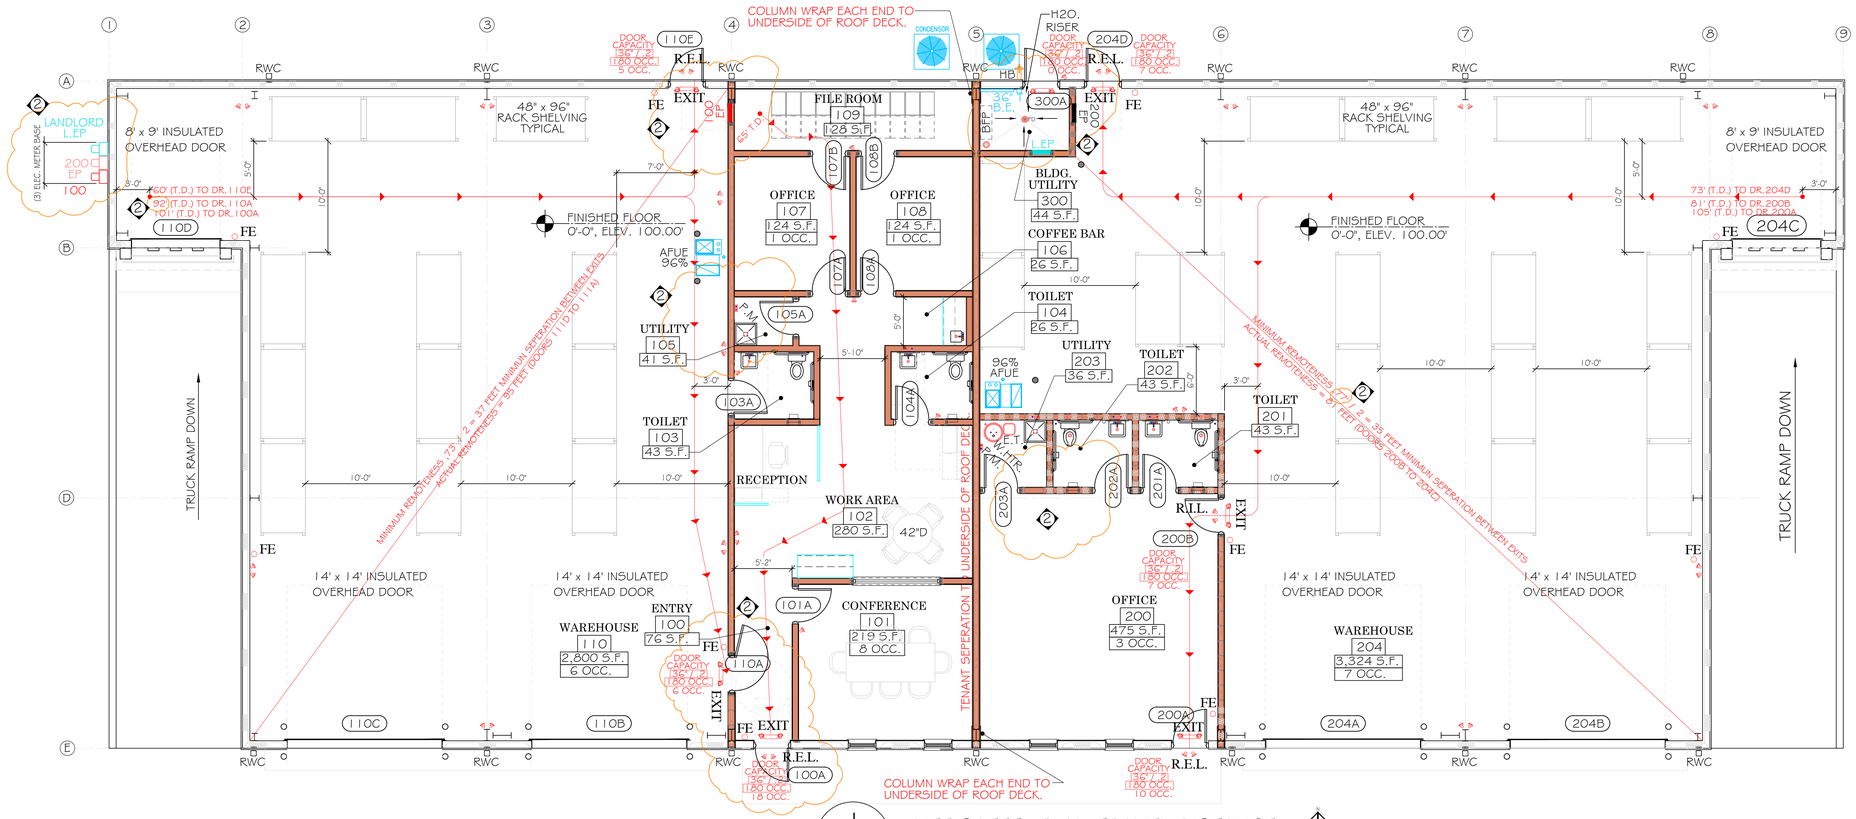

1 LSP-1 — LIFE SAFETY PLAN TRAVEL DISTANCE

SCALE: 3/16" = 1'-0"

CODE ANALYSIS

PROJECT DESCRIPTION: Reedville Business Park, Pa - P.N. 2513

THE ATTACHED PLANS FOR #5604-00270000, CENTER COUNTY, PA IS BEING SUBMITTED FOR BUILDING PERMIT. OUR PROJECT IS A 60' x 156' NEW BUILDING, LIGHT INDUSTRIAL, FLEX USE GROUP (OFFICE, WAREHOUSE, AND SHIPPING AREA) PRE-ENGINEERED METAL BUILDING, WITH AN AREA OF 8,280 GROSS AREA SQUARE FEET.TOTAL BUILDING OCCUPANT LOAD OF 28 PERSONS.

APPLICABLE CODES AND STANDARDS:

International Building Code - 2018 Edition
International Fire Code - 2018 Edition
International Plumbing Code - 2018 Edition
International Mechanical Code - 2018 Edition
International Fuel Gas Code - 2018 Edition
International Energy Conservation Code - 2018 Edition
NFPA 70 National Electnc Code - 2017 Edition
ICC A117.1 - 2009 Edition:
Amencans With Disabilities Act: 2010 Edition
National Fire Protection Association [NFPA] - Current Edition Unless Noted Otherwise:
NFPA 10 For Portable Fire Extinguishers: "Standard For Portable Fire Extinguishers"
Underwnter's Laboratones Inc.: "Fire Resistance Directory - Current Edition"

CODE COMPLIANCE:
CONSTRUCTION TYPE: TYPE IIB [IBC TABLE 601]
OCCUPANCY CLASSIFICATIONS: GROUP B - OFFICE [IBC 304.1]
GROUP S-1 - MODERATE HAZARD STORAGE [IBC 311.2].
ALLOWABLE BUILDING HEIGHT [IIB N]: B & S - 55'-0 [IBC TABLE 504.3]
ACTUAL BUILDING HEIGHT: 25'-0 TO LOWEST GRADE POINT
ALLOWABLE NUMBER OF STORIES ABOVE GRADE PLANE [IIB N]: B & S - ONE [IBC TABLE 504.4]
ACTUAL NUMBER OF STORIES: ONE STORY
ALLOWABLE AREA (IIB N) [IBC TABLE 506.2 & SECTION 506.3]
BUSINESS B - 23,000 S.F. NO FRONTAGE INCREASE NEEDED
STORAGE S-1 - 17,500 S.F NO FRONTAGE INCREASE NEEDED
ACTUAL FLOOR AREA: 8,280 SQUARE FEET FOOTPRINT TYPE IIB
OCCUPANCIES ARE NOT REQUIRED TO BE SEPARATED. FIRE RESISTANCE RATINGS FOR BUILDING ELEMENTS [IBC TABLE 601 & IBC TABLE 602]:
CONSTRUCTION TYPE IIB NS OCCCUPANCY USE GROUP B & S USE GROUP
PRIMARY STRUCTURAL FRAME: 0 HRS. 0 HRS
EXTERIOR BEARING WALLS: 1 HR. [LESS THAN 5 FT.] 0 HRS
EXTERIOR BEARING WALLS: 1 HR. [5 FT. TO LESS THAN 10 FT.] 0 HR
EXTERIOR BEARING WALLS: 1 HRS. [GREATER THAN 10 FT.] 0 HR
INTERIOR BEARING WALLS: 0 HRS. 0 HR
EXTERIOR NON-BEARING WALLS: 1 HR. [LESS THAN 5 FT.] 0 HR
EXTERIOR NON-BEARING WALLS: 1 HR. 5 FT. TO LESS THAN 10 FT.] 0 HR
EXTERIOR NON-BEARING WALLS: 0 HRS. [GREATER THAN 10 FT.] 0 HR
INTERIOR NON-BEARING WALLS: 0 HRS. 0 HR
FLOOR CONSTRUCTION: 0 HRS. 0 HR
ROOF CONSTRUCTION: 0 HRS. 0 HR
CORRIDORS SERVING MORE THAN THIRTY [30] OCC.: 0 HRS.

PORTABLE FIRE EXTINGUISHERS REQUIRED [IBC SECTION 906]
HAZARD: MODERATE
MINIMUM SIZE: 2A-10B:C [OR AS REQUIRED BY SPECIFIC USE]
MAXIMUN FLOOR AREA PER UNIT OF 'A': 1,500 SQUARE FEET [IBC TABLE 906.3(1)]
MAXIMUM FLOOR AREA PER EXTINGUISHER: 11,250 SQUARE FEET [IBC TABLE 906.3(1)]
MAXIMUM TRAVEL DISTANCE: SEVENTY-FIVE FEET [75 FT.] [IBC TABLE 906.3(1)]
BASIC MINIMUM EXTINGUISHER RATING BASED ON UNITS OF 'B': 10B [IBC TABLE 906.3(2)]
MAXIMUM TRAVEL DISTANCE: THIRTY FEET [30 FT.] [IBC TABLE 906.3(2)]
MINIMUM NUMBER REQUIRED:
REFER TO LIFE SAFETY PLAN FOR NUMBERS AND LOCATIONS OF PORTABLE FIRE EXTINGUISHERS.
SPRINKLER SYSTEM:
NOT REQUIRED FOR GROUP B, OR S-1
OCCUPANCIES UNDER ALLOWABLE SF
[IBC SECTION 903]
OCCUPANT LOAD: [IBC TABLE 1004.1.2]:
OFFICE SUITE 100 (5,512 GROSS)
B - OFFICE USE: 1,340 S.F./150 GROSS = 9 OCCUPANTS - SEE LIFE SAFETY PLAN (DESIGN FOR12)
S-1- STORAGE: 2,800 S.F./500 GROSS = 6 OCCUPANTS - SEE LIFE SAFETY PLAN
TOTAL FOR SUITE 100 = 18 OCCUPANTS (USED FOR TOILET ROOM COUNT)
OFFICE SUITE 200 (5,512 GROSS)
B - OFFICE USE: 475 S.F./150 GROSS = 3 OCCUPANT (3 BY DESIGN) SEE LIFE SAFETY PLAN
S-1- STORAGE: 3,324 S.F./500 GROSS = 7 OCCUPANTS (7 BY DESIGN) SEE LIFE SAFETY PLAN
TOTAL FOR SUITE 200 = 10 OCCUPANTS (USED FOR TOILET ROOM COUNT)
TOTAL BUILDING OCCUPANCY = 28 OCCUPANTS
WIDTH OF EXITS REQUIRED [IBC TABLE 1004.5 & SECTION 1005]:
B - OFFICE USE: DOOR WIDTH IN INCHES / 0.20 = DOOR OCCUPANCY CAPACITY,36 INCH DOOR PROVIDED. 36 (DOOR LEAF) / .20 = 180 PEOPLE PER DOOR
NUMBER OF EXITS [IBC TABLE 1006.2.1]: (SUITES 100,200)
B OCCUPANCY, ONE EXIT REQUIRED (BASED ON OCCUPANCY LOAD). ONE [1] EXIT PROVIDED (LESS THAN 30 OCCUPANTS)
MAX. TRAVEL DISTANCE 75'-0"
S OCCUPANCY, ONE EXIT REQUIRED (BASED ON OCCUPANCY LOAD). TWO [2] EXITS PROVIDED, DUE TO TRAVEL DISTANCE EXCEEDING 100'-0" OF TRAVEL (LESS THAN 29 OCCUPANTS)
MAX. TRAVEL DISTANCE 100'-0"
DOORS:
DOORS SHALL HAVE A MINIMUM CLEAR WIDTH OF NOT LESS -THAN THIRTY-TWO INCHES [32 IN.] MEASURED BETWEEN THE FACE OF THE DOOR AND THE STOP, WITH THE DOOR OPEN TO NINETY DEGREES [90 DEG.]. WHEN THERE ARE PAIRS OF DOORS, ONE LEAF SHALL MEET THIS REQUIREMENT. MAXIMUM WIDTH OF DOOR LEAF IS FORTY-EIGHT INCHES [48 IN.]. [IBC PARAGRAPH 1010.1.1]
DOORS SHALL SWING IN THE DIRECTION OF EGRESS TRAVEL WERE SERVING AN OCCUPANT LOAD OF FIFTY [50] OR MORE. [IBC PARAGRAPH 1010.1.2.1]

MAXIMUM TRAVEL DISTANCE [S] [IBC TABLE 1017.2]: B & S - 200'-0. SEE TRAVEL DISTANCE ON LIFE SAFETY PLAN
MAXIMUM DEAD END CORRIDOR: [IBC ARTICLE 1020.4] B & S [5] FIFTY [20 FT.] NO DEAD-END CORRIDORS.

REQUIRED PLUMBING FIXTURES [IBC ARTICLE 2902.2]:
USE GROUP B, S - 28 OCCUPANTS FOR THE ENTIRE BUILDING [2 UNISEX TOILET ROOMS FOR SUITE 100,200]
SUITE 100 = 18 OCCUPANTS
SUITE 200 = 10 OCCUPANTS
TOTAL OCCUPANTS FOR THIS PROJECT = 28 OCCUPANTS
WATER URINALS: N/A BY DESIGN
LAVATORIES: PER DESIGN
WATER CLOSET: PER DESIGN
DRINKING FOUNTAIN: BOTTLED WATER TO BE PROVIDED EACH SUITE
COFFEE BAR SINK: PER DESIGN SUITE 100 AT THIS TIME.
SUITE 100: [IBC TABLE 2902.1]:
OFFICE AREA
UNISEX BATHROOM
1 / 25 1ST 50 OCC:
OFFICE OCCUPANCY BY DESIGN IS 12; 1 TOILET FIXTURE REQUIRED MIN. ONE PROVIDED.
1 / 40 1ST 80 OCC:
OFFICE OCCUPANCY BY DESIGN IS 12; 1 LAVATORY FIXTURE REQUIRED MIN. ONE PROVIDED.
STORAGE / WAREHOUSE
UNISEX BATHROOM
1 / 100 OCC:
WAREHOUSE OCCUPANCY BY DESIGN IS 6; 1 TOILET FIXTURE REQUIRED MIN. ONE PROVIDED.
1 / 100 OCC:
WAREHOUSE OCCUPANCY BY DESIGN IS 6; 1 LAVATORY FIXTURE REQUIRED MIN. ONE PROVIDED.
MOP SERVICE BASINS: 1 PROVIDED.
SUITE 200: [IBC TABLE 2902.1]:
OFFICE AREA
UNISEX BATHROOM
1 / 25 1ST 50 OCC:
OFFICE OCCUPANCY BY DESIGN IS 3; 1 TOILET FIXTURE REQUIRED MIN. ONE PROVIDED.
1 / 40 1ST 80 OCC:
OFFICE OCCUPANCY BY DESIGN IS 3; 1 LAVATORY FIXTURE REQUIRED MIN. ONE PROVIDED.
STORAGE / WAREHOUSE
UNISEX BATHROOM
1 / 100 OCC:
WAREHOUSE OCCUPANCY BY DESIGN IS 7; 1 TOILET FIXTURE REQUIRED MIN. ONE PROVIDED.
1 / 100 OCC:
WAREHOUSE OCCUPANCY BY DESIGN IS 7; 1 LAVATORY FIXTURE REQUIRED MIN. ONE PROVIDED.
MOP SERVICE BASINS: 1 PROVIDED.
ACCESSIBILITY: FULLY COMPLIANT FOR THE PARKING, ENTRY, OFFICE AREA AND TOILET ROOMS, INCLUDING, BUT NOT LIMITED TO, MEANS OF ENTRY; MEANS OF EGRESS; ACCESSIBLE COUNTERS; TOILET ROOM FIXTURES AND SIGNAGE.

Eldon R. Stoltzfus, Architect
Architecture • Planning • Interior Design
2 South Decatur Street Strasburg, Pennsylvania 17579
Phone: (717) 291-5928 Fax: (717) 291-9053 E-mail: estoltzfus@ersarchitect.com

THIS DRAWING AS AN INSTRUMENT OF SERVICE IS THE PROPERTY OF THE ARCHITECT AND MAY NOT BE REPRODUCED WITHOUT THIS PERMISSION AND UNLESS THE REPRODUCTION CARRIES HIS NAME AS THE ARCHITECT

REVISIONS:

1	05/12/2025	MOVED PROJECT TO BUILDING 2 SITE
2	07/02/2026	CODE REVIEW COMMENT RESPONSES & CHANGES

REGISTERED PROFESSIONAL ARCHITECT COMMONWEALTH OF PENNSYLVANIA ELDON R. STOLTZFUS No. 25863-X

DRAWN BY: DR	FILE NAME: 2513 -LSP-1
SCALE: AS NOTED	DATE: 27-11-25

THE CONTRACTOR SHALL CHECK CONDITIONS IN PLACE AND OBTAIN OR VERIFY ALL NECESSARY DIMENSIONS BEFORE BEGINNING WORK.

LIFE SAFETY PLAN / TRAVEL DIST. / CODE DATA

156' x 60' NEW BUILDING AT REEDVILLE BUSINESS PARK
BELLOWS RD., LOWER OXFORD TWP.
CHESTER COUNTY, PA 19363

JOB NO: 2513

DRAWING NO: LSP-1