AHWATUKEE FOOTHILLS HEALTH CENTER

4545 E CHANDLER BOULEVARD, PHOENIX, AZ 85050

Floor 03

Suite 304

AS-BUILT

4,579 SF

AVAILABLE

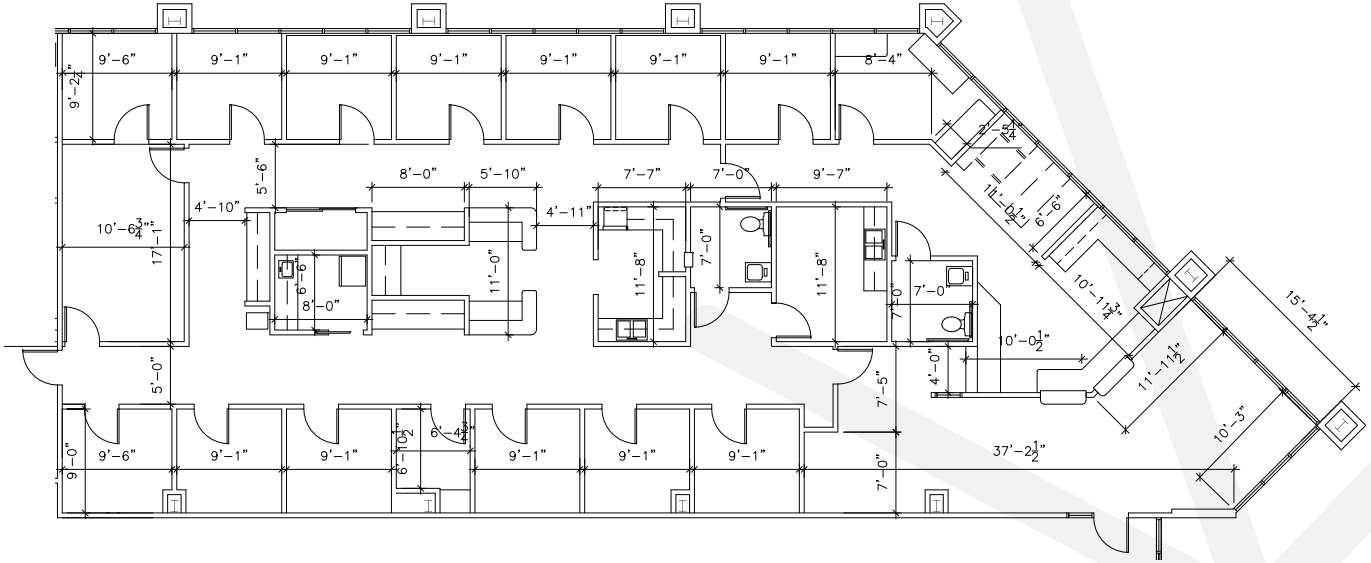

RACHAEL THOMPSON
Senior Vice President
602.513.5122
rachael.thompson@kidder.com

PERRY GABUZZI, CCIM
Executive Vice President
602.513.5116
perry.gabuzzi@kidder.com

View Portfolio

Kidder Mathews