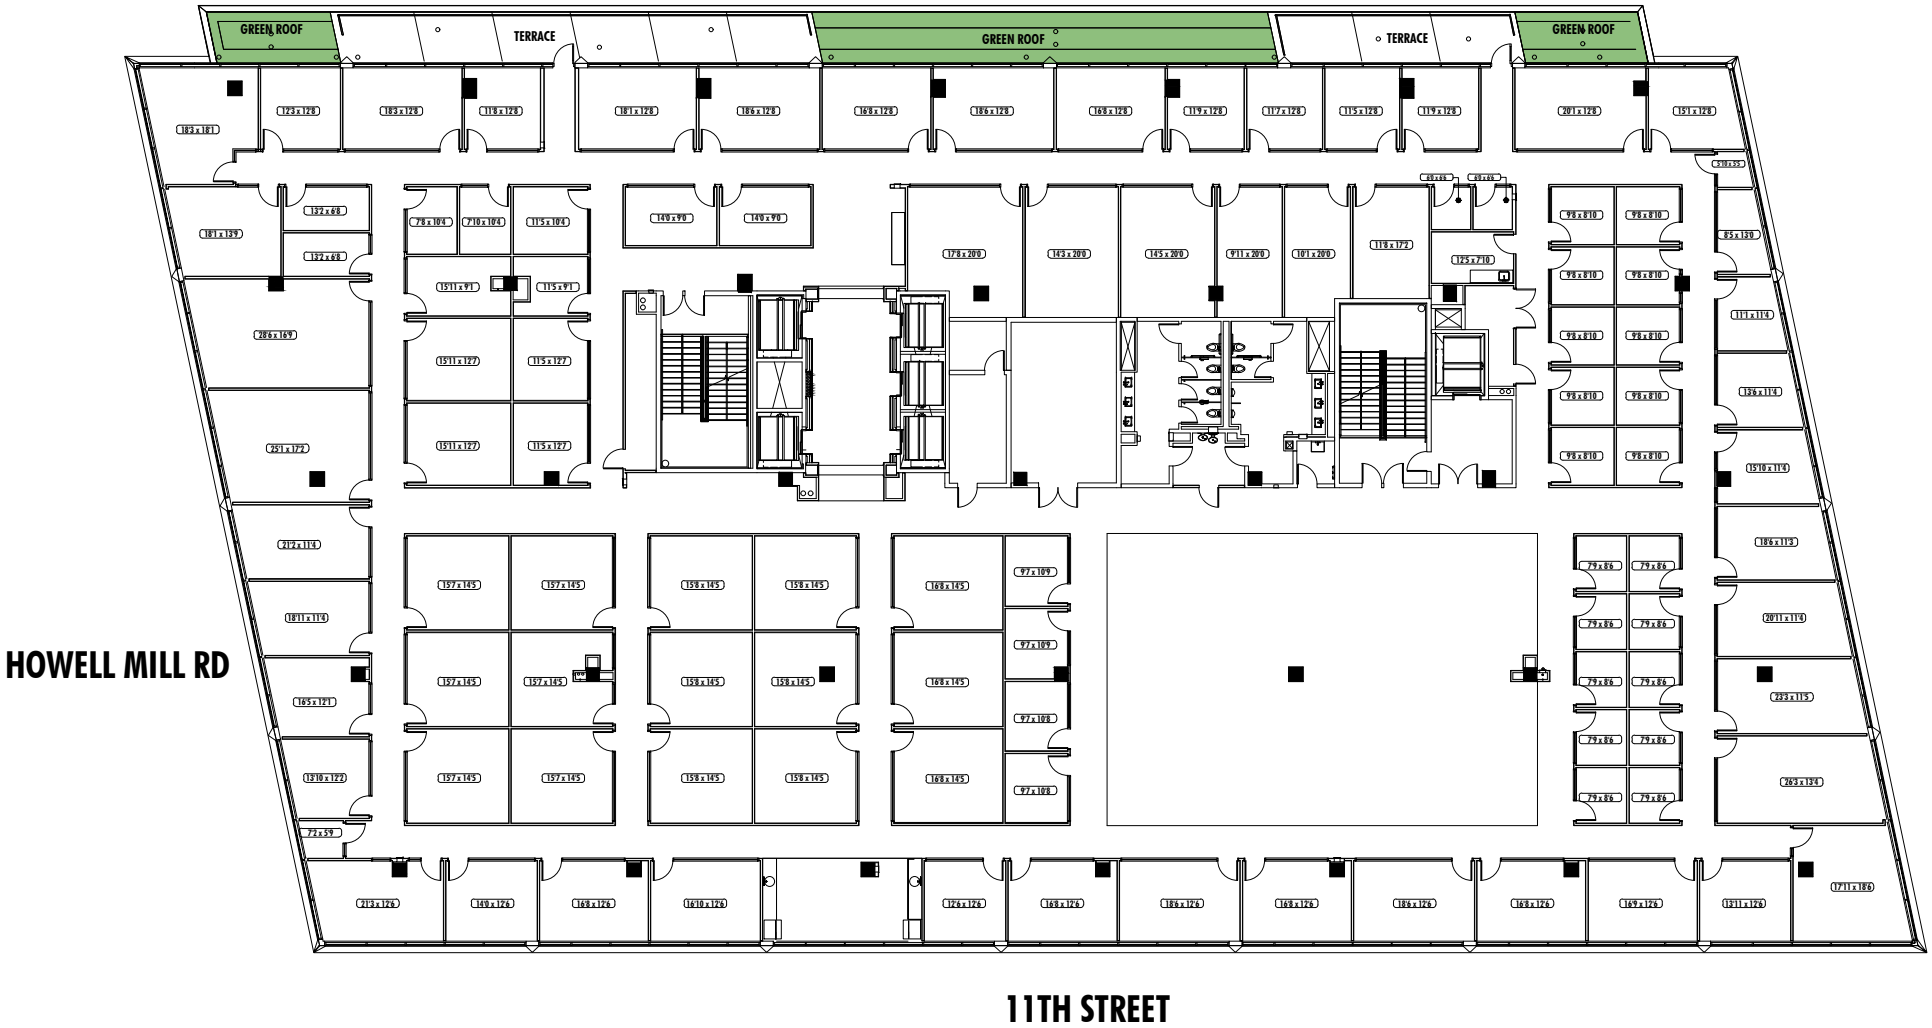

NELSON **Star Metals • Suite 900 • 36,571 RSF** **Available Suite**