5310 W THUNDERBIRD ROAD, GLENDALE, AZ 85306

THUNDERBIRD MEDICAL PLAZA III

Floor 01

Suite 100/103

AS-BUILT

5,620 SF

AVAILABLE

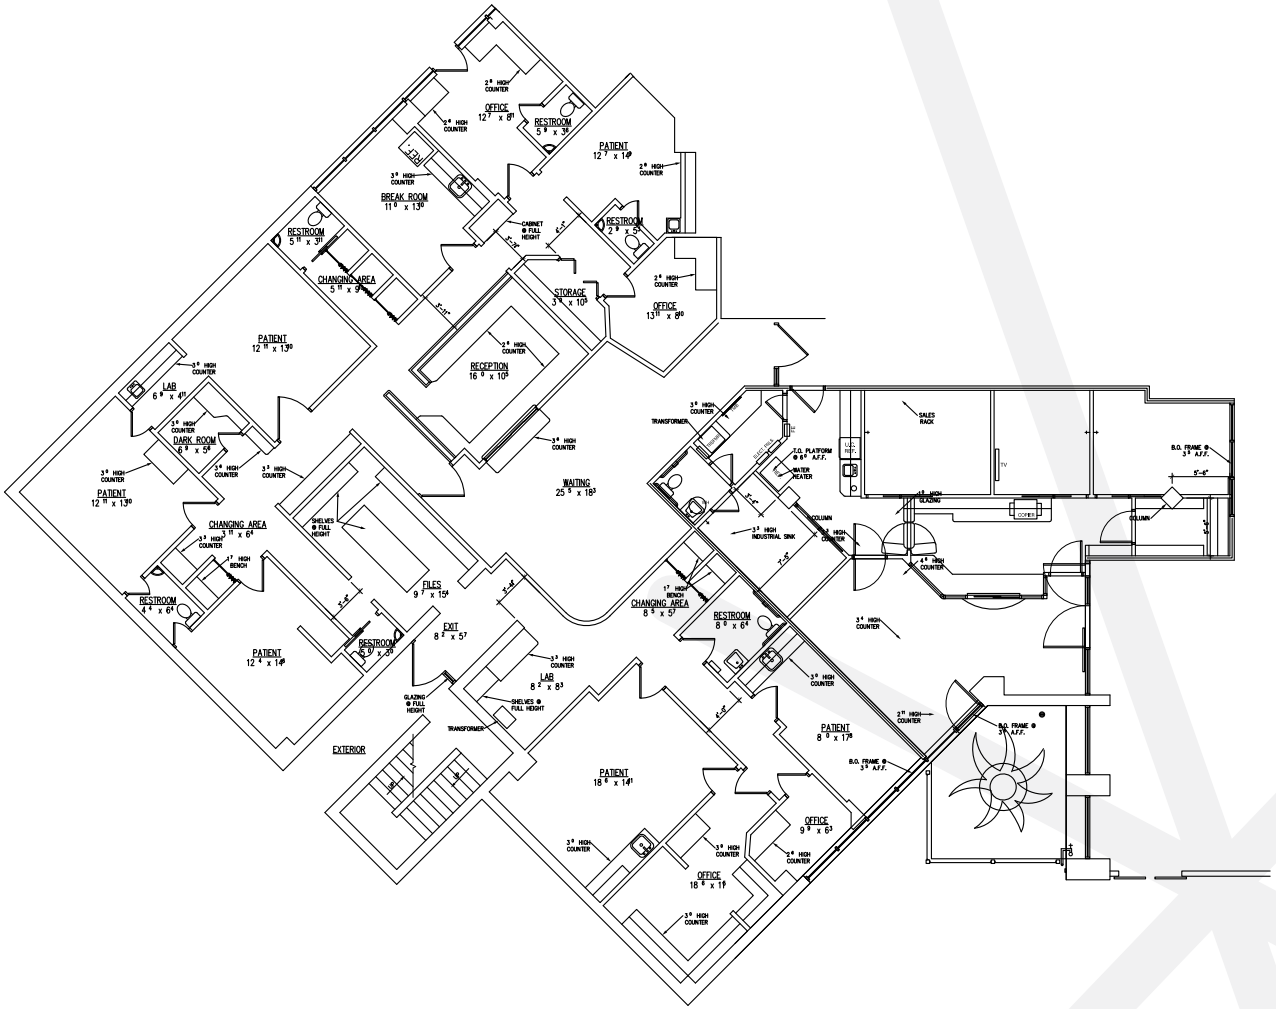

RACHAEL THOMPSON
Senior Vice President
602.513.5122
rachael.thompson@kidder.com

PERRY GABUZZI, CCIM
Executive Vice President
602.513.5116
perry.gabuzzi@kidder.com

View Portfolio

Kidder Mathews