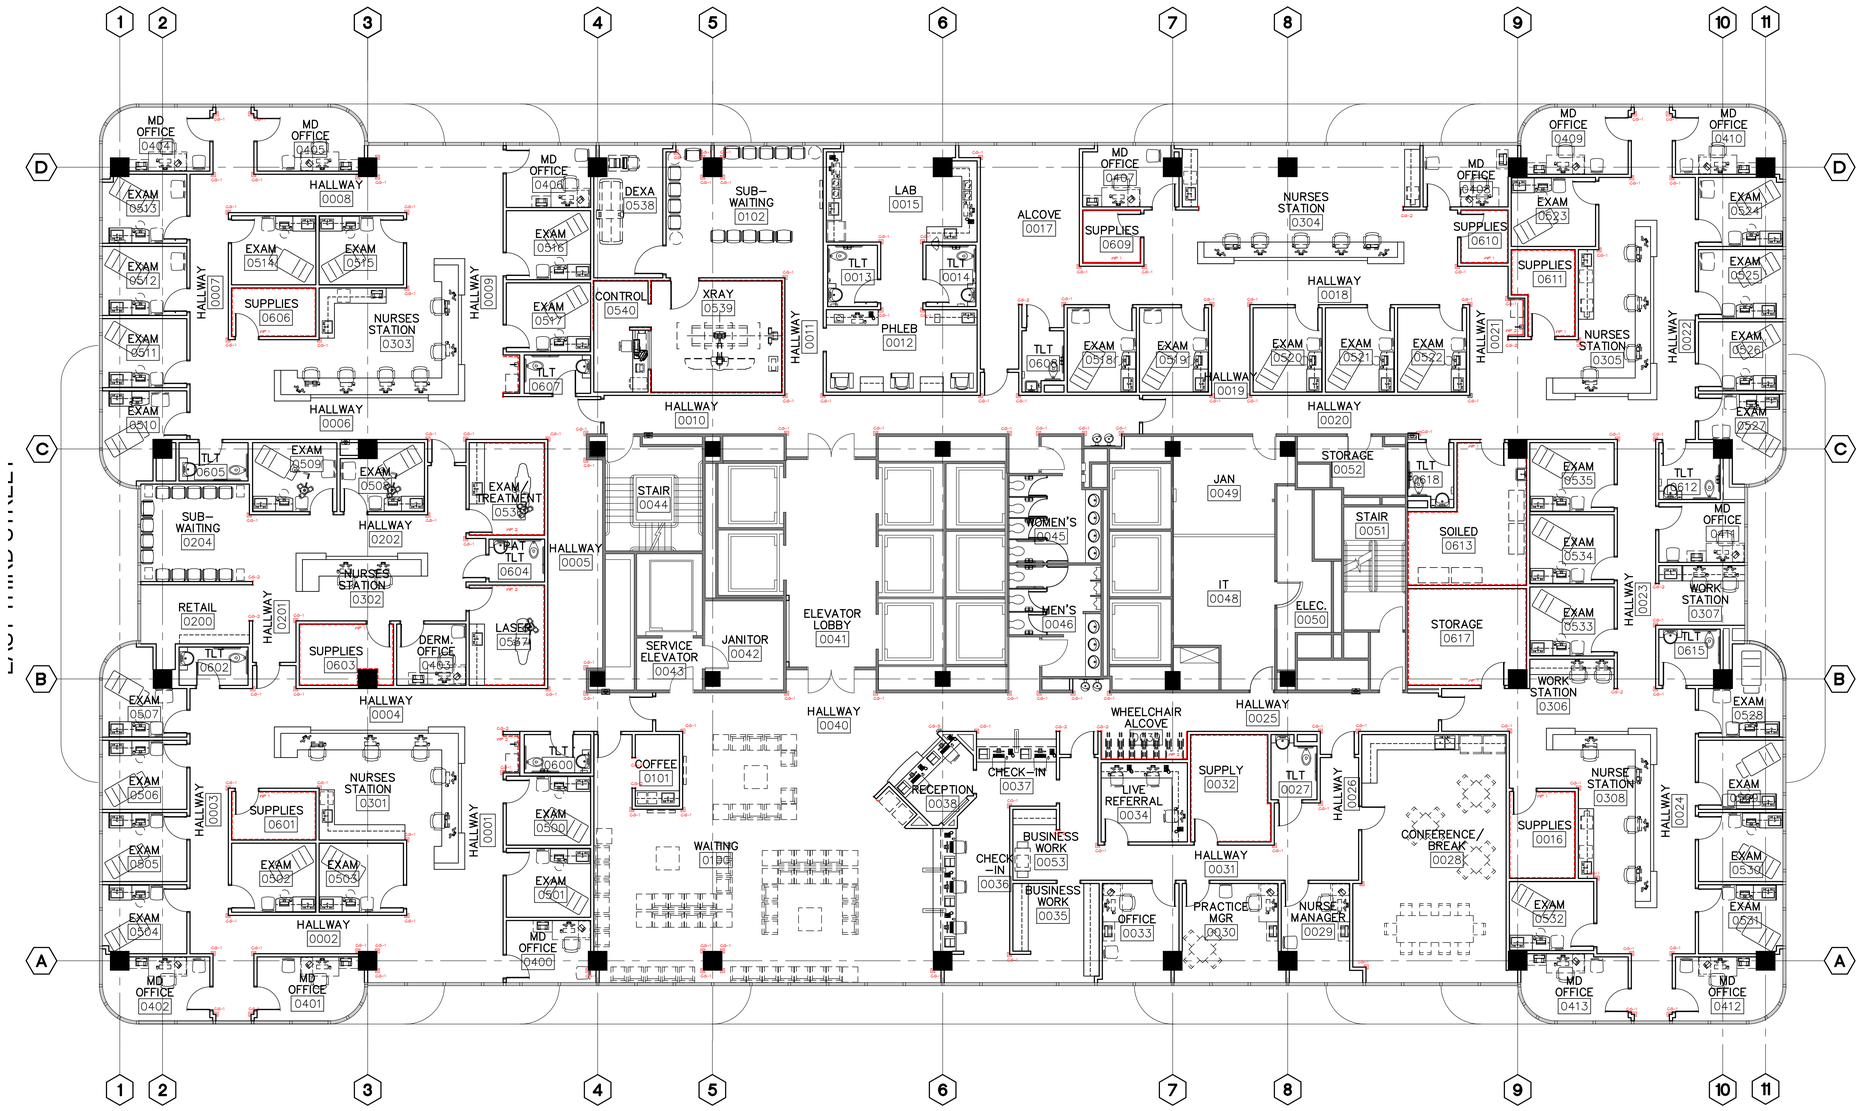

R:\PROJECTS\BUSINESS\B1808 MMG UPTOWN UPFIT\40 CONSTRUCTION DOCUMENTS\B1808 A101 12TH FLOOR.DWG (A601 THIRTEENTH FLOOR SP PLAN) 04/27/15 - 9:37AM