KEY NOTES:

1. STOREFRONT SYSTEM
2. STAIR
3. ELEVATOR
4. PLANT WELL
5. MECHANICAL SHAFT
6. CATWALK ABOVE
7. MECH. FURRDOWN ABOVE
8. PARTIAL HEIGHT WALL
9. EXISTING COLUMN
10. ROOF OVERHANG

GENERAL NOTES:

1. CONTRACTOR TO FIELD VERIFY ALL EXISTING CONDITIONS AND NOTIFY ARCHITECT OF ANY DISCREPANCY, P.T.C.

LEGEND:

TYPE: A EXTERIOR WALL – MASONRY BRICK W/ 3 5/8" METAL STUDS W/ 5/8" GYP. BOARD

TYPE: B EXTERIOR WALL – MASONRY BRICK OVER CMU BLOCK W/ 3 5/8" METAL STUDS W/ 5/8" GYP. BOARD

TYPE: C EXTERIOR WALL – MASONRY BRICK OVER CONCRETE BLOCK W/ 1 7/8" METAL STUDS W/ 5/8" GYP. BOARD

TYPE: D INTERIOR WALL – NON RATED PARTITION: 3 5/8" METAL STUDS W/ 5/8" GYP. BOARD BOTH SIDES

ROOM 100 ROOM NAME AND ROOM NUMBER

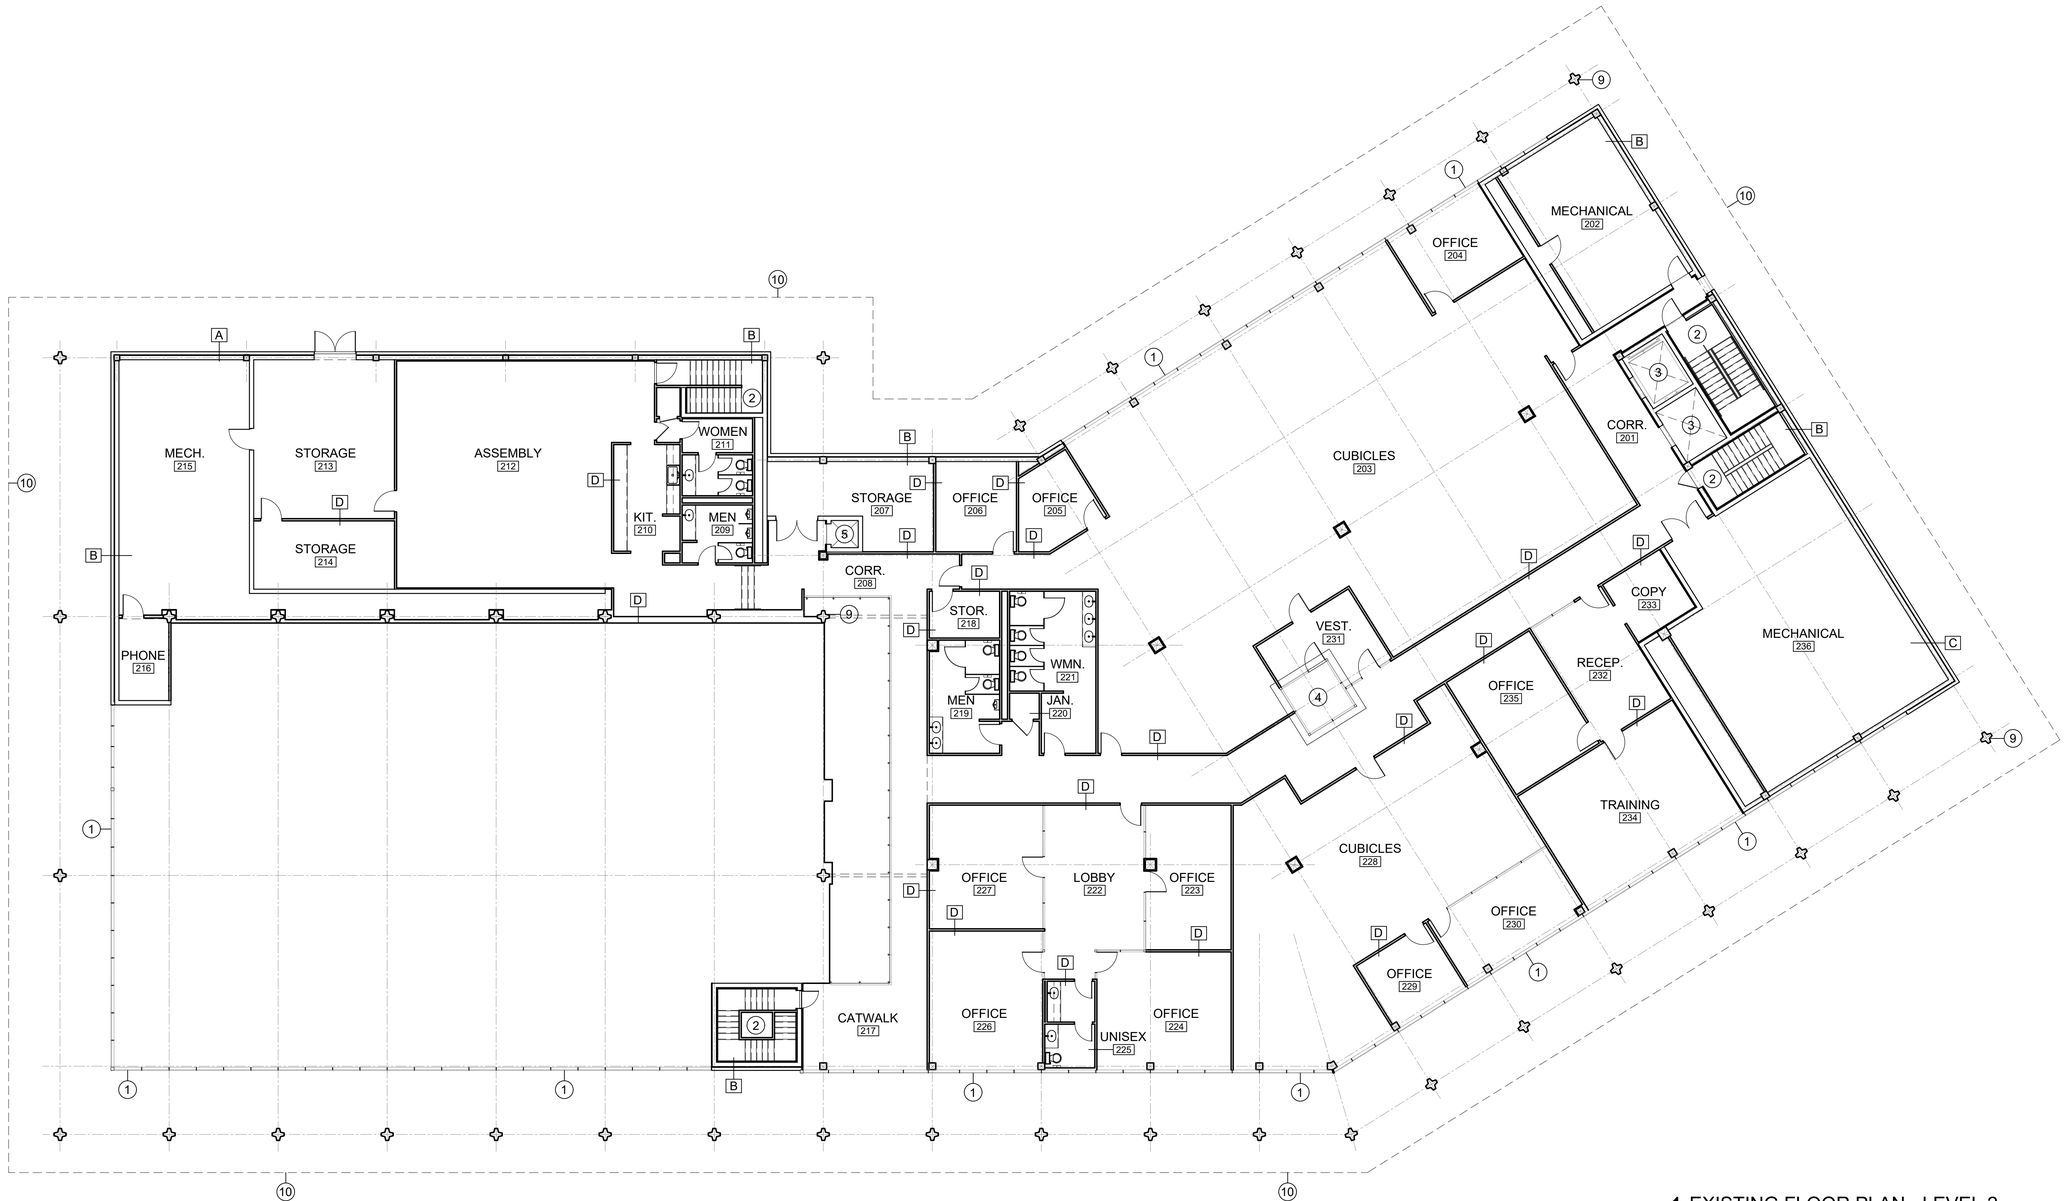

1 EXISTING FLOOR PLAN - LEVEL 2
SCALE: 1/16" = 1'-0"

ACS architecture | asbuilts
multifamily hospitality industrial commercial
1322 Space Park Drive
Suite B-122
Houston • Texas 77058
info@acs-architecture.com
281.767. 9000 voice
Firm Registration No. BR2307

STONEWATER PROPERTIES

ACS.2020.0315

4215 SOUTH STAPLES STREET
CORPUS CHRISTI, TX 78411

© ACS architecture | asbuilts

2020 ACS ARCHITECTURE, LLC DOCUMENTS AND INSTRUMENTS OF SERVICE ARE GIVEN IN CONFIDENCE AND REMAIN THE PROPERTY OF ACS ARCHITECTURE, LLC. THIS DOCUMENT AND THE INFORMATION CONTAINED HEREIN MAY NOT BE DUPLICATED, USED, OR DISCLOSED WITHOUT WRITTEN CONSENT OF ACS ARCHITECTURE, LLC. THIS IS AN UNPUBLISHED SURVEY DOCUMENT OFFERED BY ACS ARCHITECTURE, LLC. IT IS SUBMITTED FOR YOUR PERSONAL USE IN CONNECTION WITH THE CONTRACTED PROJECT PERFORMED BY ACS ARCHITECTURE, LLC. ALL OR ANY PART OF THE SURVEY DOCUMENT (EXCEPTING REGISTERED TRADEMARKS) REMAINS THE PROPERTY OF ACS ARCHITECTURE, LLC.

Revision Date:

Issue/Date

ASBUILTS: 04-02-2020

A2.02

OVERALL FLOOR PLAN
LEVEL 2
GENERAL INFORMATION