TOLD partners INC.
INDUSTRIAL/COMMERCIAL REAL ESTATE

EXHIBIT A
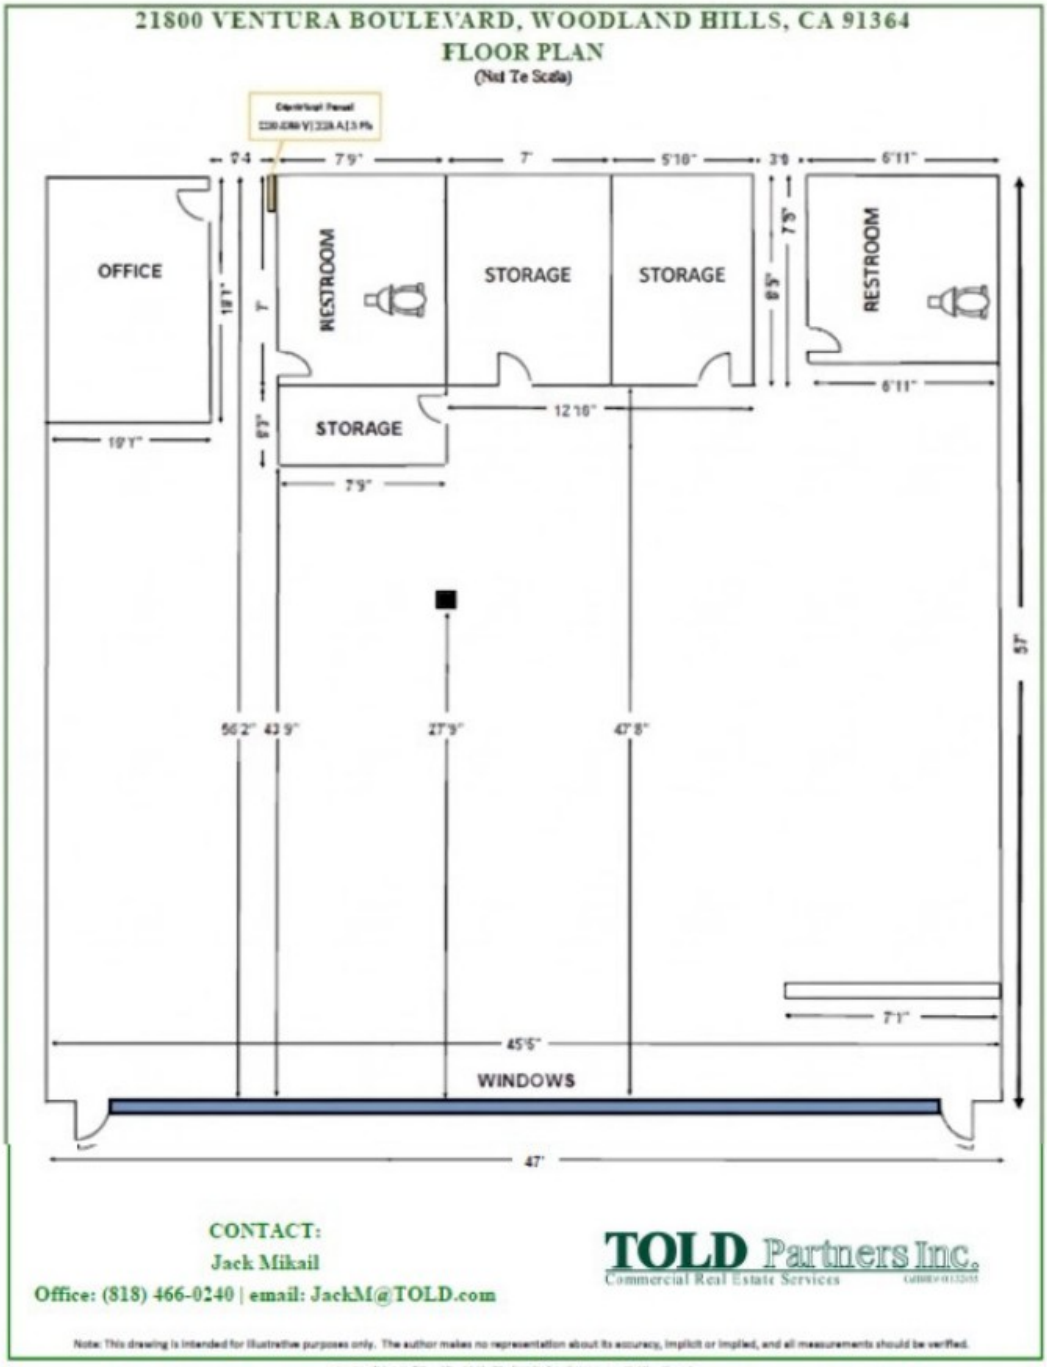
AS BUILT FLOOR PLAN