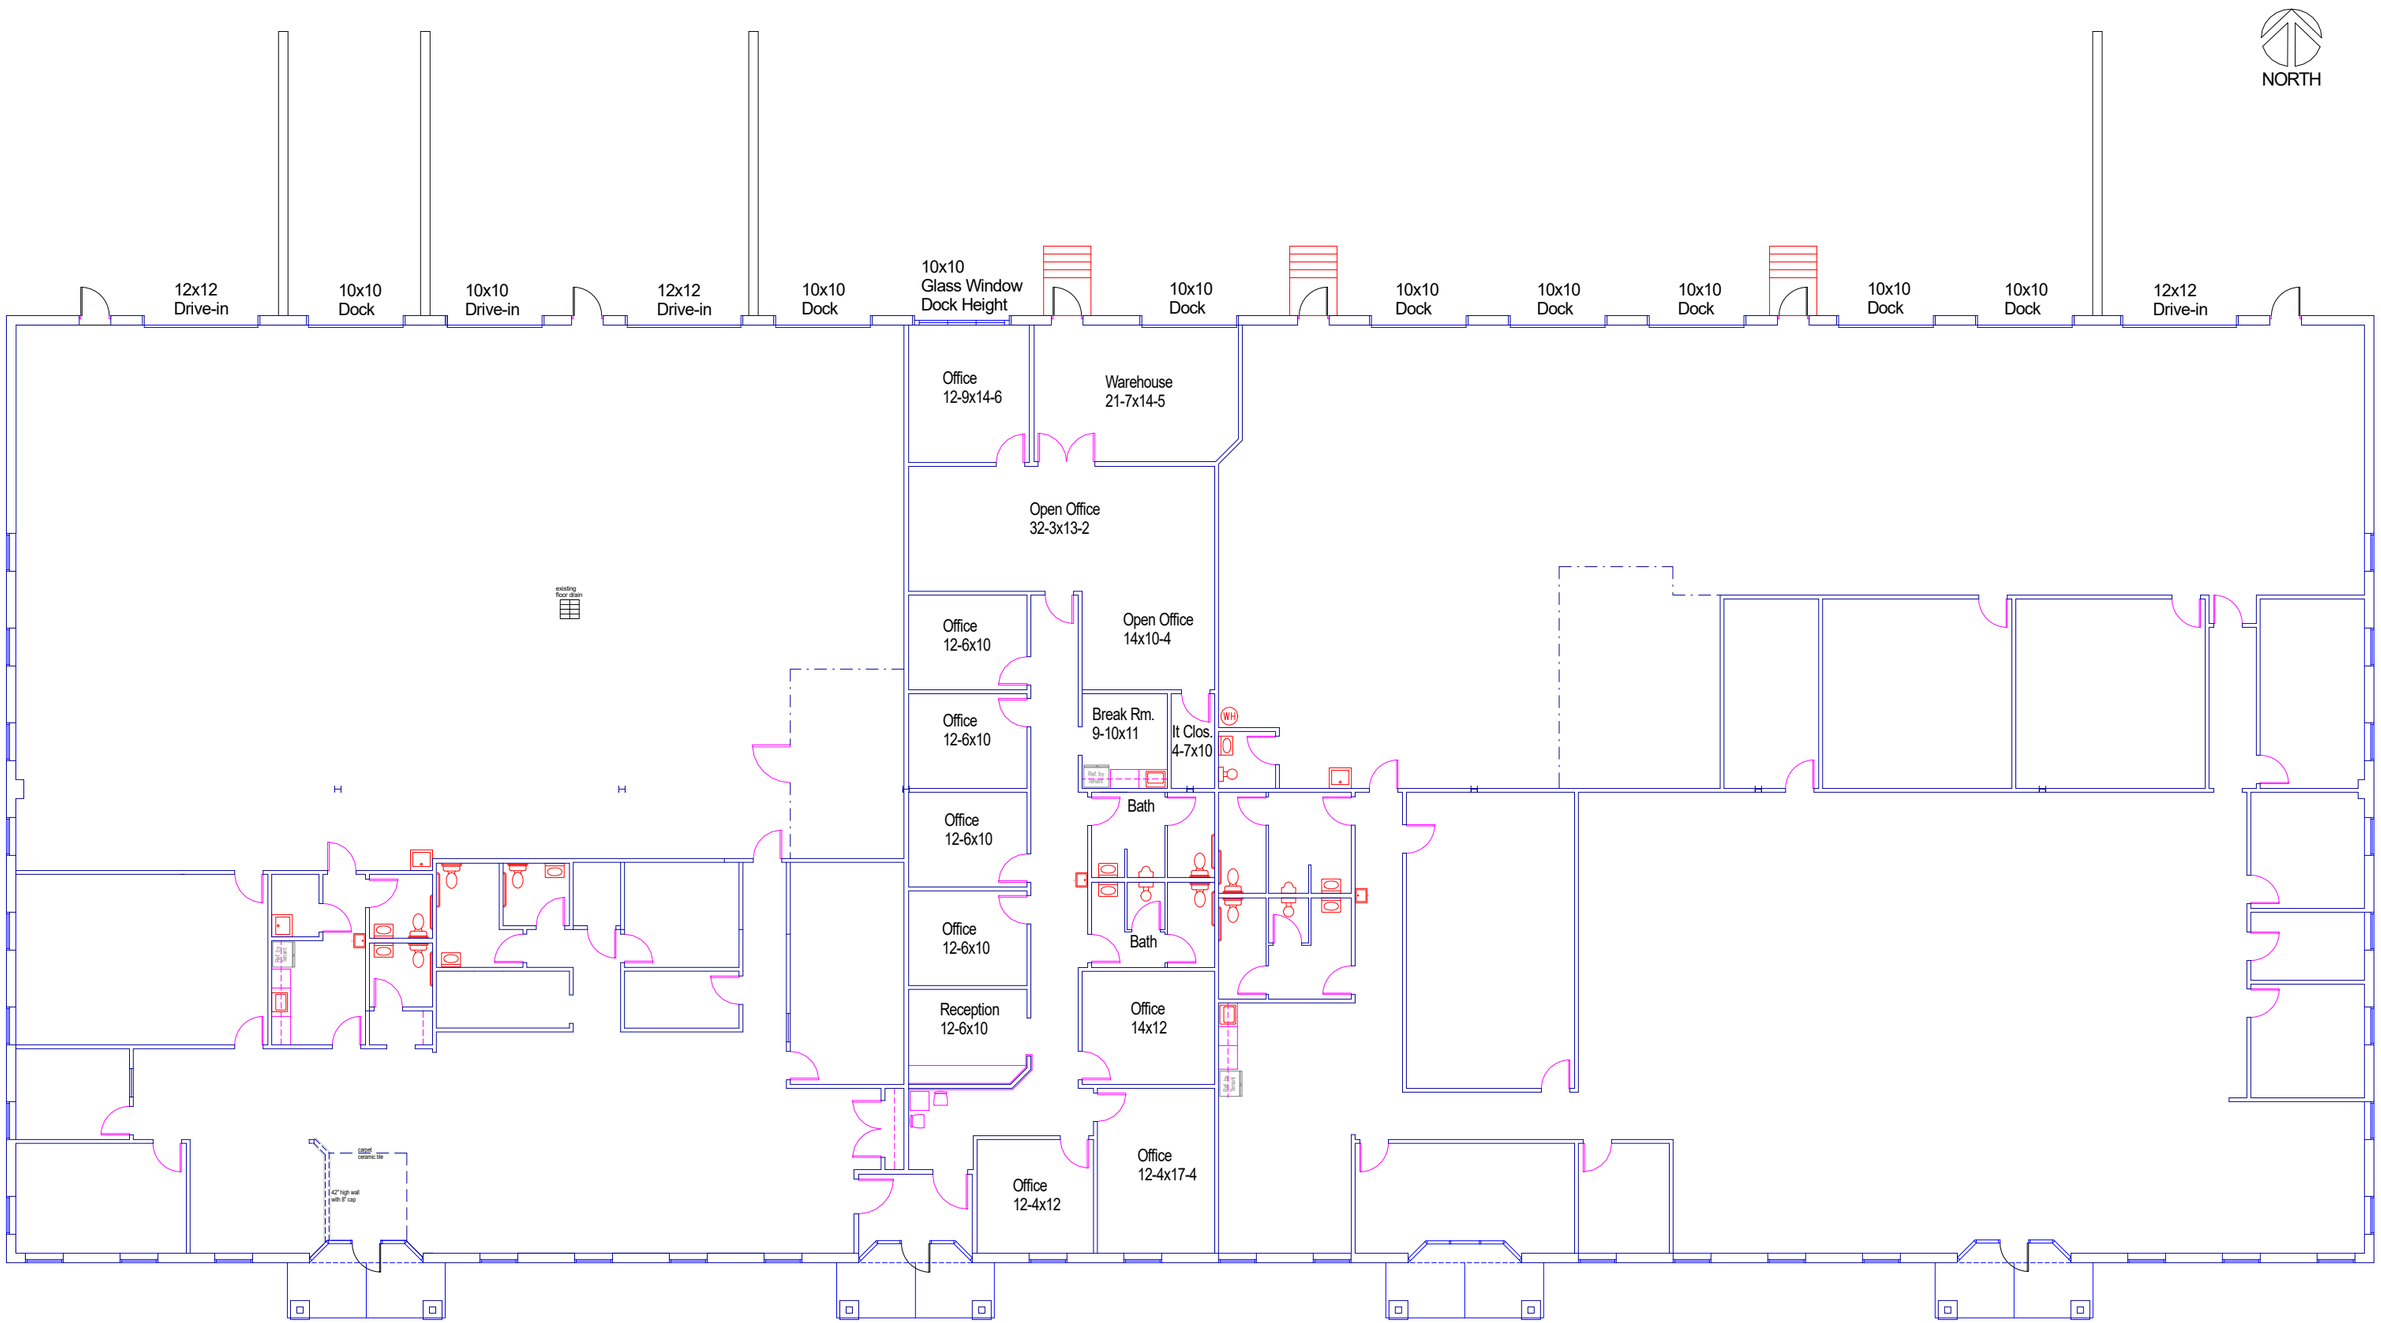

BLDG. # D-8	OLIVA DEVELOPMENT, LLC
DRAWING DATES: 3/7, 3/13, 3/27/24	
DRAWN BY: SJR	6731 Collamer Road E. Syracuse, NY 13057
SCALE: 1/16" = 1'	

Exhibit A
Suite 3 - 3,330 SF