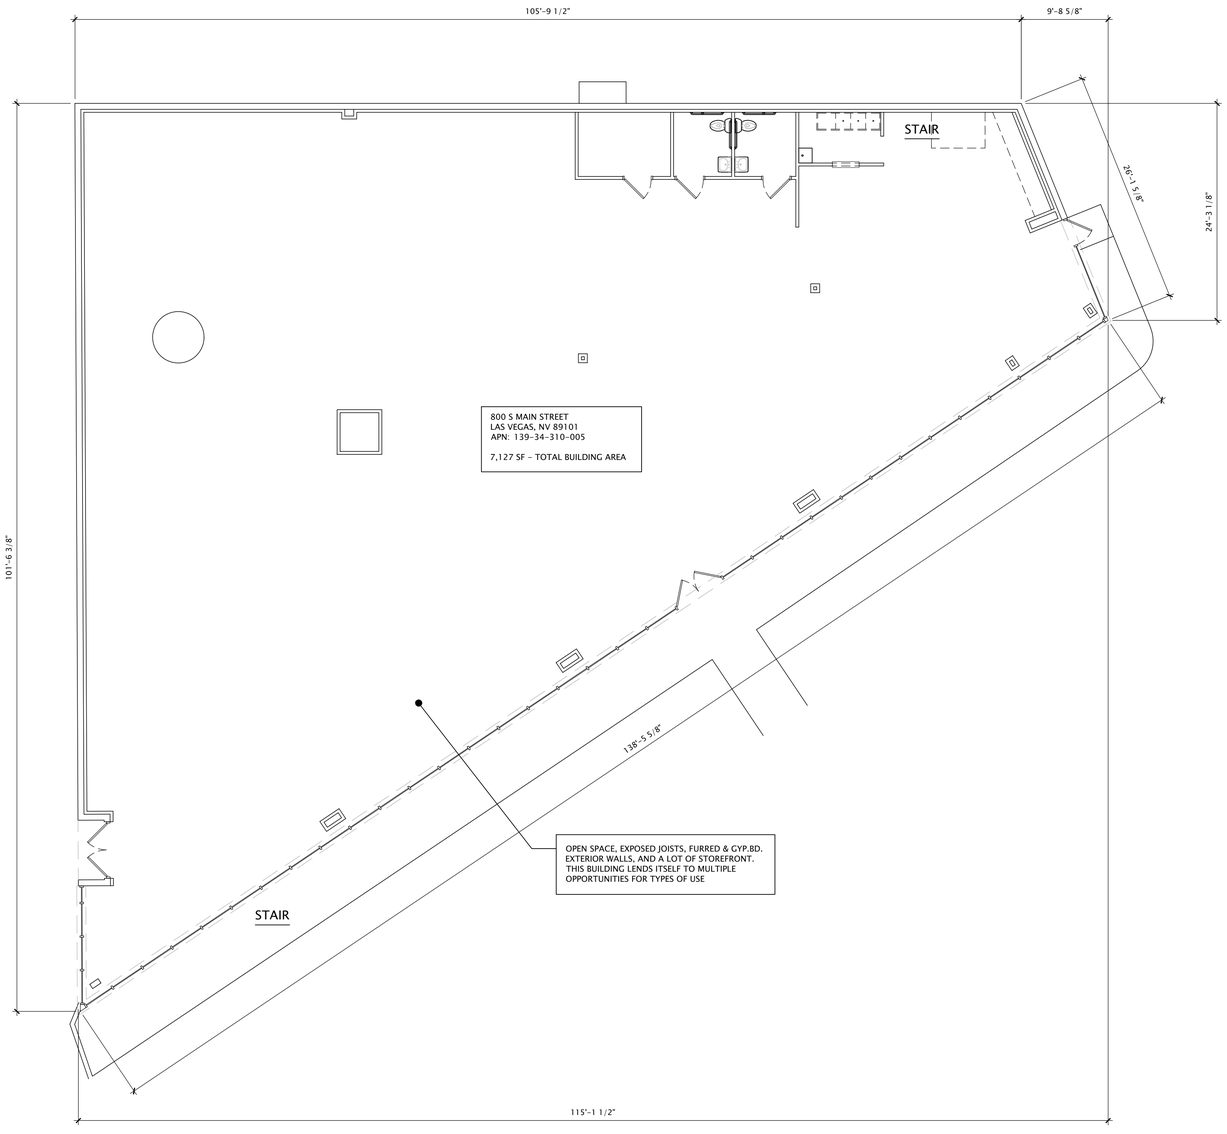

1 EXISTING FLOOR PLAN - 800 S. MAIN

A1.4 SCALE: 1/8" = 1'-0"

NORTH

TRINITY HAVEN
DEVELOPMENT

FIRM - NAME & ADDRESS:

TRINITY HAVEN DEVELOPMENT
100 S. MARYLAND PARKWAY SUITE 210
LAS VEGAS, NV 89101
702-204-8737

MULTI-JURISDICTIONAL
LICENSE #0075064

*COPYRIGHT - TRINITY HAVEN DEVELOPMENT 2022

PROJECT - NAME & ADDRESS:

EXISTING BUILDING AREA

800, 808, 818 S MAIN STREET
LAS VEGAS, NV 89104

NO.	REVISION / ISSUE	DATE
	REVIEW	06.21.24

SHEET DESCRIPTION:

EXISTING FLOOR PLAN
800 S. MAIN

-

PROJECT #	24-024
DATE	-
SCALE	AS NOTED

SHEET (24x36)

A1.4