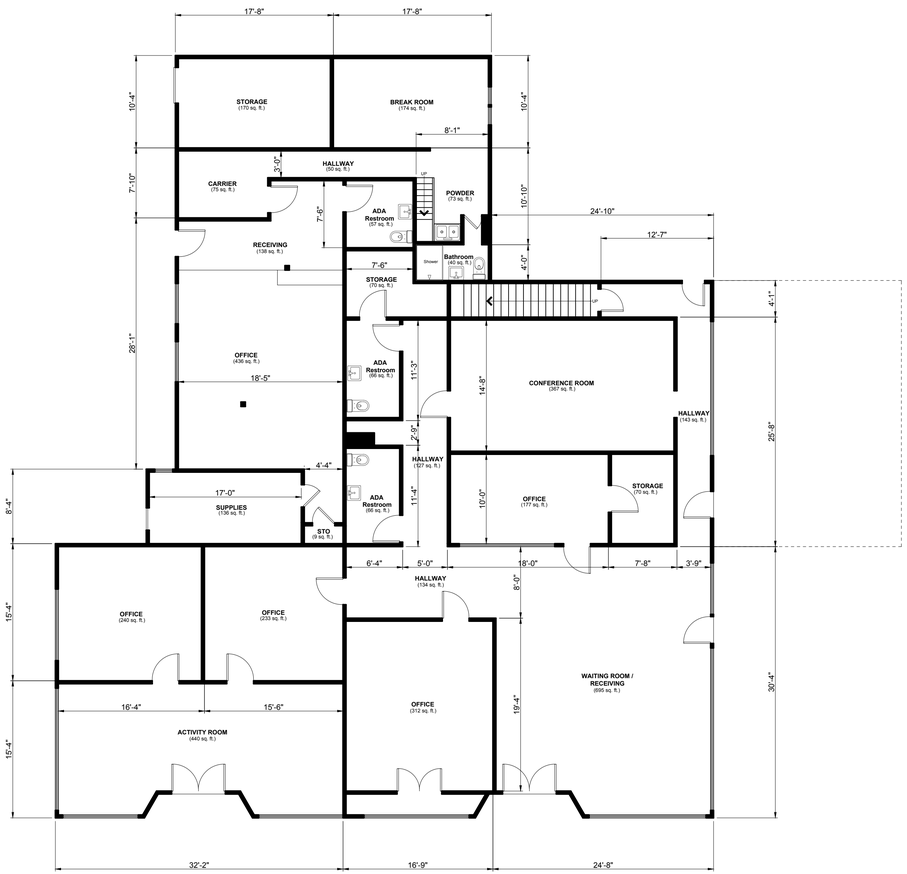

NORTH

A 02 **BUILDING "A" 1ST FLOOR PLAN (E)**

SCALE: 1/8" = 1'- 0" AREA: 4,885 SQ. FT.

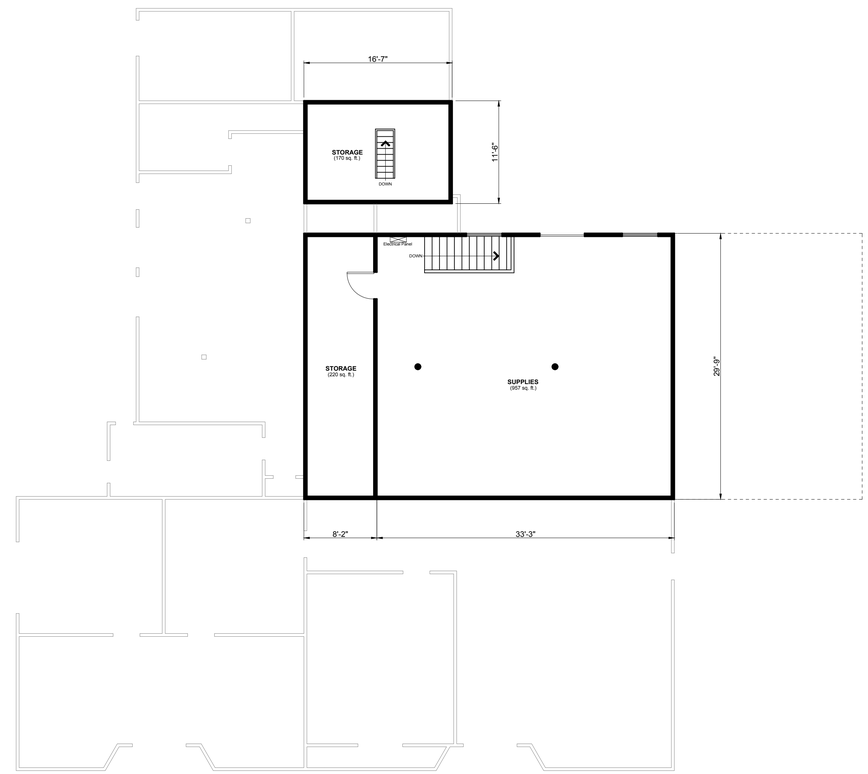

NORTH

B 02 **BUILDING "A" 2ND FLOOR PLAN (E)**

SCALE: 1/8" = 1'- 0" AREA: 1,350 SQ. FT.

V·C
VIRAY CONCEPT

ViravConcept@Gmail.Com
510.776.8738

CONSULTANT

PREPARED BY

JHUN VIRAY
510.776.8738

PROJECT INFORMATION

SHA & SKY PROPERTIES, INC.
600 Broadway St. Vallejo CA 94590

AS-BUILT PLAN

DESCRIPTION

REVISION HISTORY

1
2
3
4
5

DATE 06.05.2018

SCALE As Noted

SHEET NAME BUILDING "A" FLOOR PLANS

SHEET NUMBER A-02