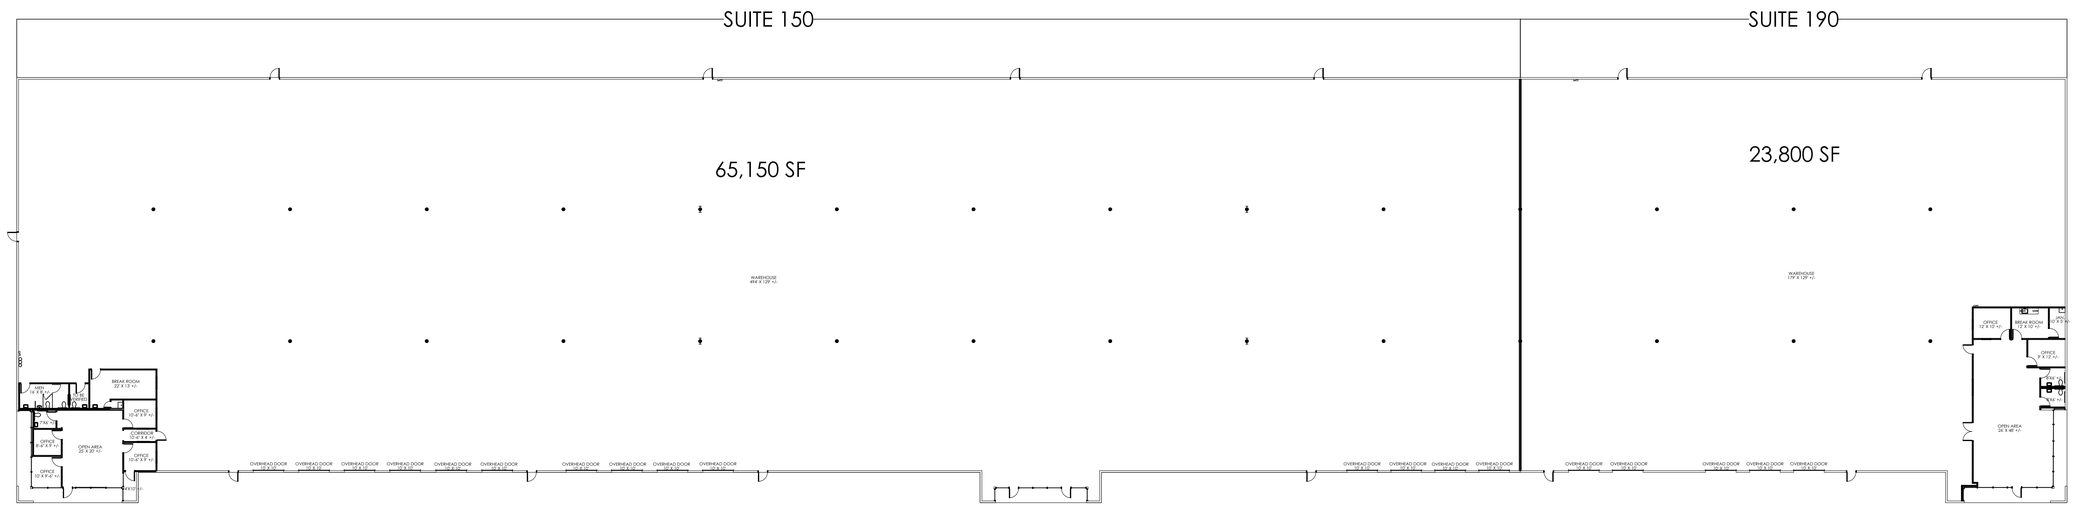

AS-BUILT BUILDING FLOOR PLAN

NOT TO SCALE

N

SPS

IEQT | EXETER

RYAN CRABTREE
M: 817-944-4343

A 88,950 SF AS BUILT
FOR MARKETING

5201 CATRON DR.
DALLAS, TEXAS

Copyright © 2023
Space Planning Specialists
These drawings, or parts thereof, may not be reproduced in any form, by any method, for any purpose, without prior written consent from Space Planning Specialists

SPACE PLANNING SPECIALISTS
COMMERCIAL SPACE PLANNING
& INTERIOR DESIGN
(972) 414-9391
@SpacePlanningSpecialists.com

SCALE: NO SCALE
on 42"x30" plot

ISSUE DATES:
1/19/2023
AS-BUILT MARKETING
NOT FOR
CONSTRUCTION

SHEET A1
OF 03 SHEET(S)

NFC
NOT FOR CONSTRUCTION
THIS PLAN HAS NOT BEEN SEALED BY A LICENSED INTERIOR DESIGNER

01/19/2023