ALL DESIGNS, PLANS, SPECIFICATIONS, AND/OR DETAILS SHOWN ON THIS SHEET ARE THE PROPERTY OF LAWRENCE ABELL & ASSOCIATES LTD. COPYRIGHT, COMMON LAW COPYRIGHT AND ALL OTHER APPLICABLE PROPERTY RIGHTS ARE HEREBY RESERVED FOR LAWRENCE ABELL & ASSOCIATES LTD. NO PART OF THIS SHEET IS TO BE REPRODUCED, CHANGED, COPIED OR USED IN ANY FORM WITHOUT WRITTEN PERMISSION FROM LAWRENCE ABELL & ASSOCIATES LTD.

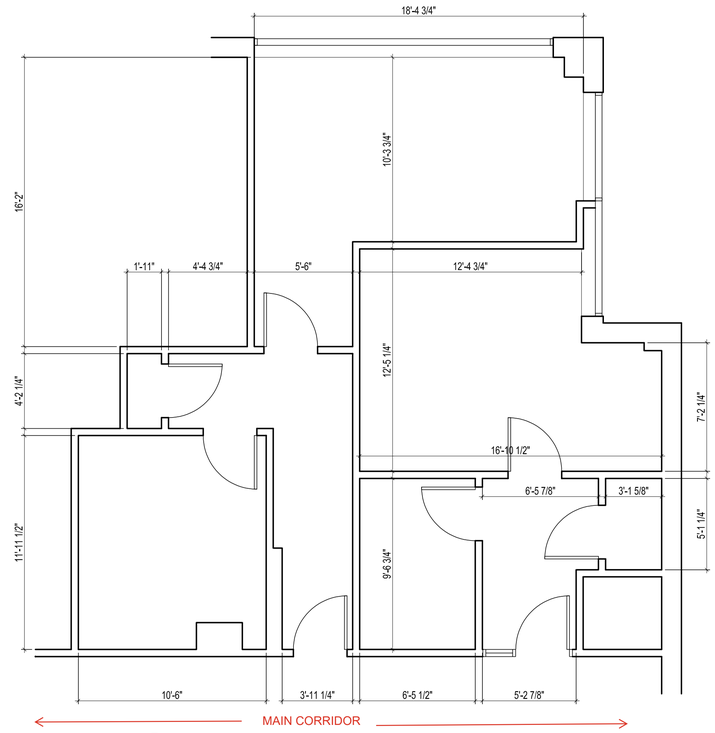

1 A1.1 EXISTING FLOOR PLAN
SCALE: 1/4" = 1'-0"

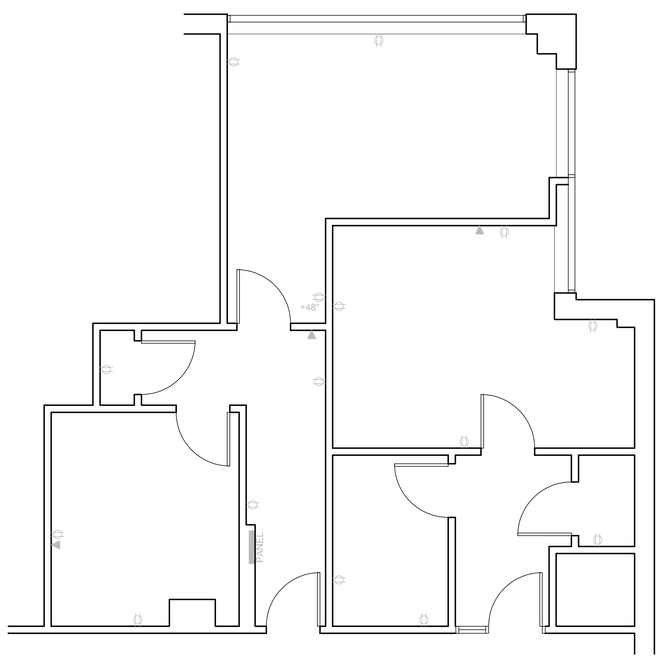

3 A1.1 EXISTING ELECTRICAL PLAN
SCALE: 1/4" = 1'-0"

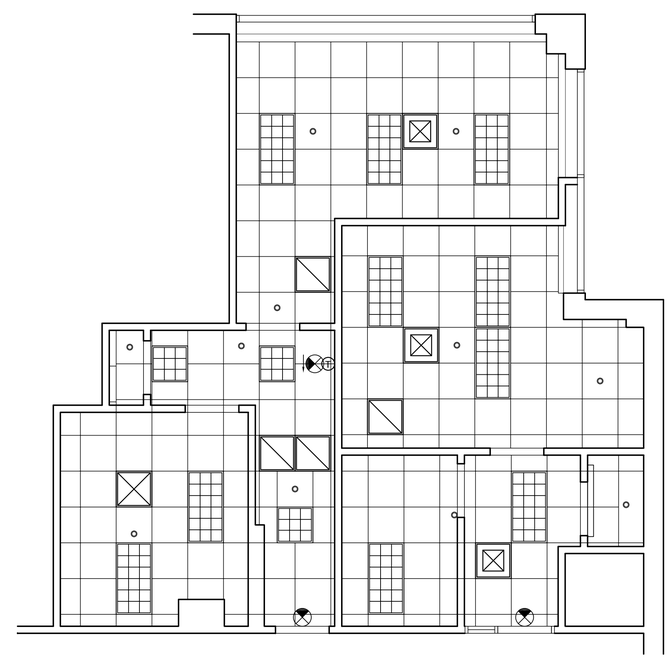

2 A1.1 EXISTING REFLECTED CEILING PLAN
SCALE: 1/4" = 1'-0"

REVISIONS		
NUMBER	DESCRIPTION	DATE

AS-BUILT DOCUMENTS
FOR
PRINCE FREDERICK MARKET SQUARE SUITE 209
PRINCE FREDERICK, MARYLAND

OWNER INFORMATION	
OWNER:	
ADDRESS:	
PHONE:	
EMAIL:	

LAWRENCE ABELL & ASSOCIATES LTD.
ARCHITECTS ~ PLANNERS

ARCHITECT INFORMATION	
CONTACT:	STEPHEN ABELL
ADDRESS:	314 EAST CHARLES STREET LA PLATA, MD 20646
PHONE:	301-932-1900
EMAIL:	SABELL@LAA.CC

EXISTING FLOOR PLANS

PROJECT NUMBER:	26-040.03
DATE:	05-18-2026
DRAWN BY:	A.H.
CHECKED BY:	S.A.

A1.1

SCALE: AS NOTED