TAGS & LABELS

DOORS

ELECTRICAL

FIRE PROTECTION

GAS

HVAC

LIGHTING

PLUMBING

OTHER

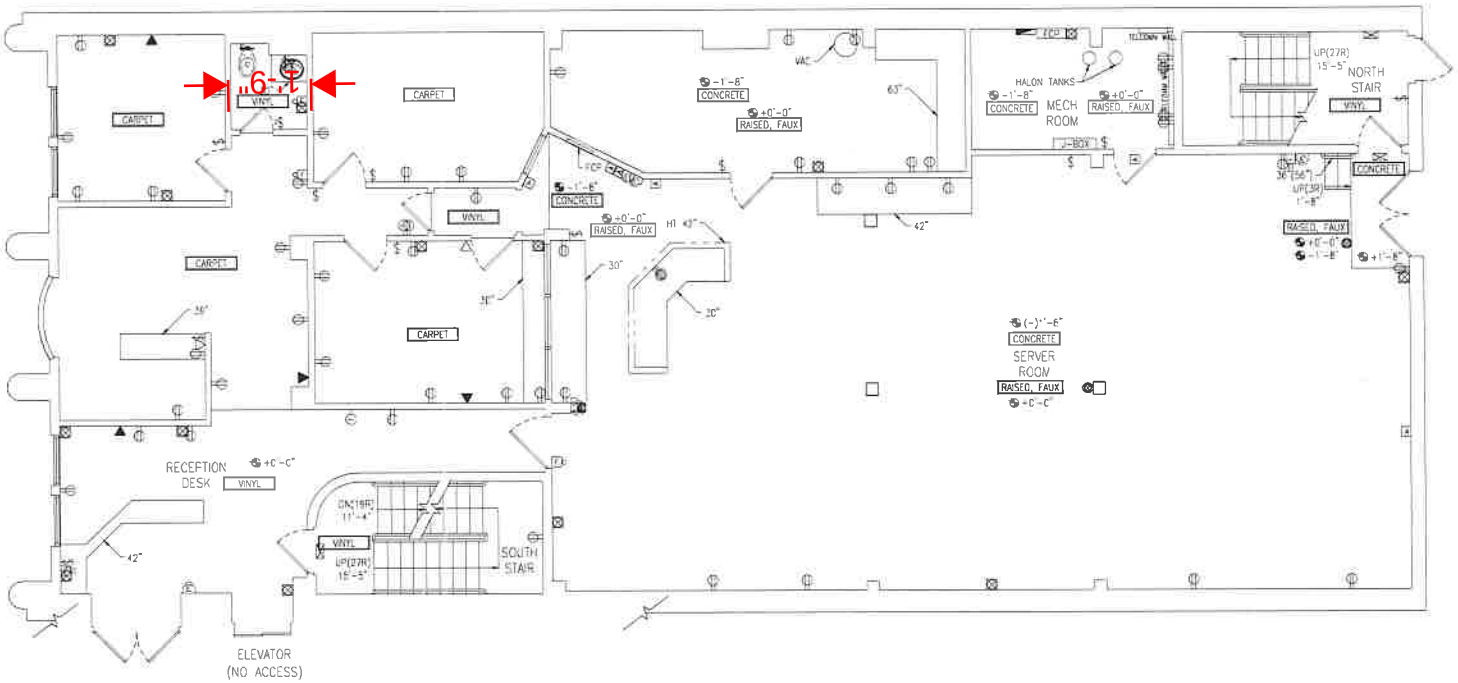

GROUND LEVEL FLOOR PLAN UNIT: 101, Sq. Ft.: 3,372 SCALE: 1/4" = 1'-0"

HAMILTON

HAMILTON DEVELOPMENT
3250 DICKERSON PIKE, SUITE 114
NASHVILLE, TN 37207

Drawn By L. HANSON
Checked By CRAWFORD
Project Number 224165

ANNEX BUILDING
111 E 7TH STREET
CHATTANOOGA, TN 37402

COAST 2 COAST
7704 BASSWOOD DR
CHATTANOOGA, TN 37416
PH 423.255.9000
www.coast2coast.net

Date 02/16/2022

A201