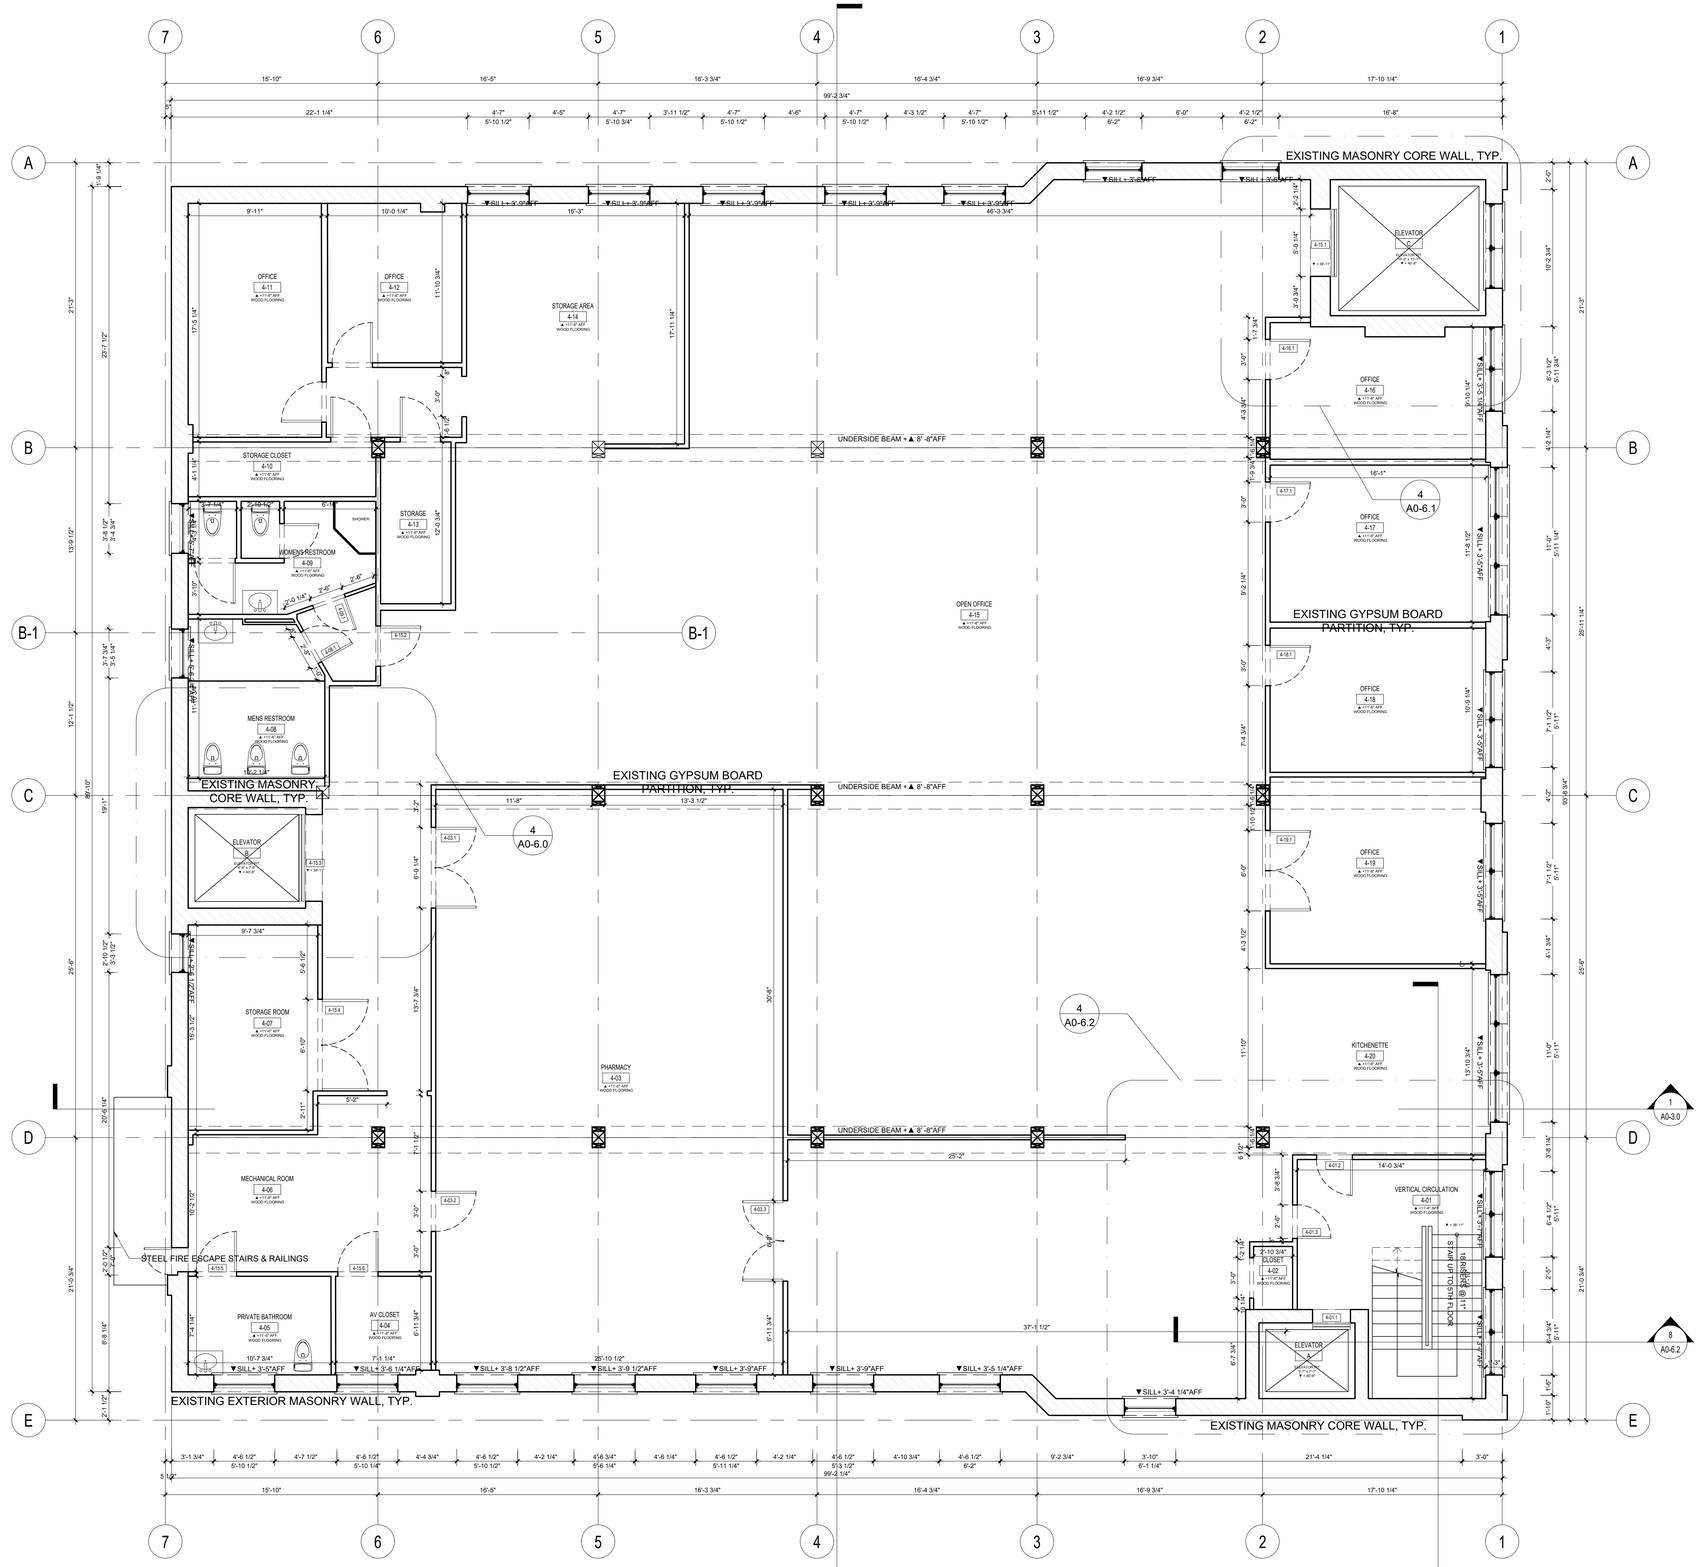

1 FOURTH FLOOR PLAN

SCALE: 0 1' 2' 4' 8'

JDD

ARCHITECTS

johndesalvodesign.com

1300 NORTH ASTOR STREET, CHICAGO, IL 60610 / 312.543.8277

OWNERS:
OLIVE PROPERTIES, LLC
2003 W. FULTON, SUITE 401

CONTRACTORS:
TBD

PRELIMINARY / NOT FOR CONSTRUCTION

DRAWINGS LIST

A0-00	ABBREV., MATL. & GENERAL NOTES
A0-01	EXIT PLANS, SITE & LOCATION PLAN
A0-02	AS-BUILT FOUNDATION PLAN
A0-03	AS-BUILT 1ST FLOOR PLAN
A0-04	AS-BUILT 2ND FLOOR PLAN
A0-05	AS-BUILT 3RD FLOOR PLAN
A0-06	AS-BUILT 4TH FLOOR PLAN
A0-07	AS-BUILT 5TH FLOOR PLAN
A0-08	AS-BUILT ROOF DECK PLAN
A0-09	AS-BUILT ROOF PLAN
A0-10	AS-BUILT EAST ELEVATION
A0-11	AS-BUILT NORTH ELEVATION
A0-12	AS-BUILT SOUTH ELEVATION
A0-13	AS-BUILT WEST ELEVATION
A0-14	AS-BUILT SECTION 1
A0-15	AS-BUILT SECTION 2

NO.	DESCRIPTION	DATE
1	ISSUED FOR INFORMATION/ OWNER REVIEW	-

PROJECT NUMBER -

COMMERCIAL OFFICE BUILDING
2003 W. FULTON
Chicago, Illinois

SHEET

AS-BUILT
4TH FLOOR PLAN

A0-06