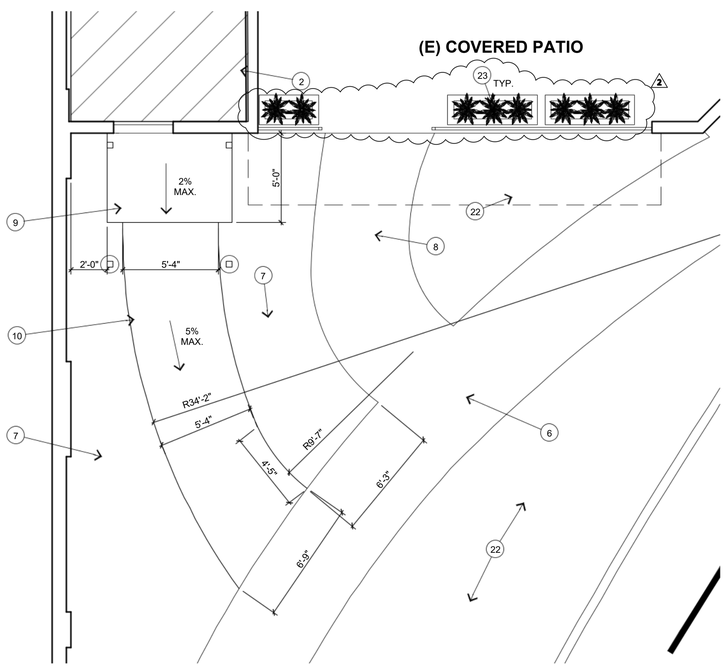

1 TO-GO - EXTERIOR PLAN

SCALE: 1/4" = 1'-0"

NORTH

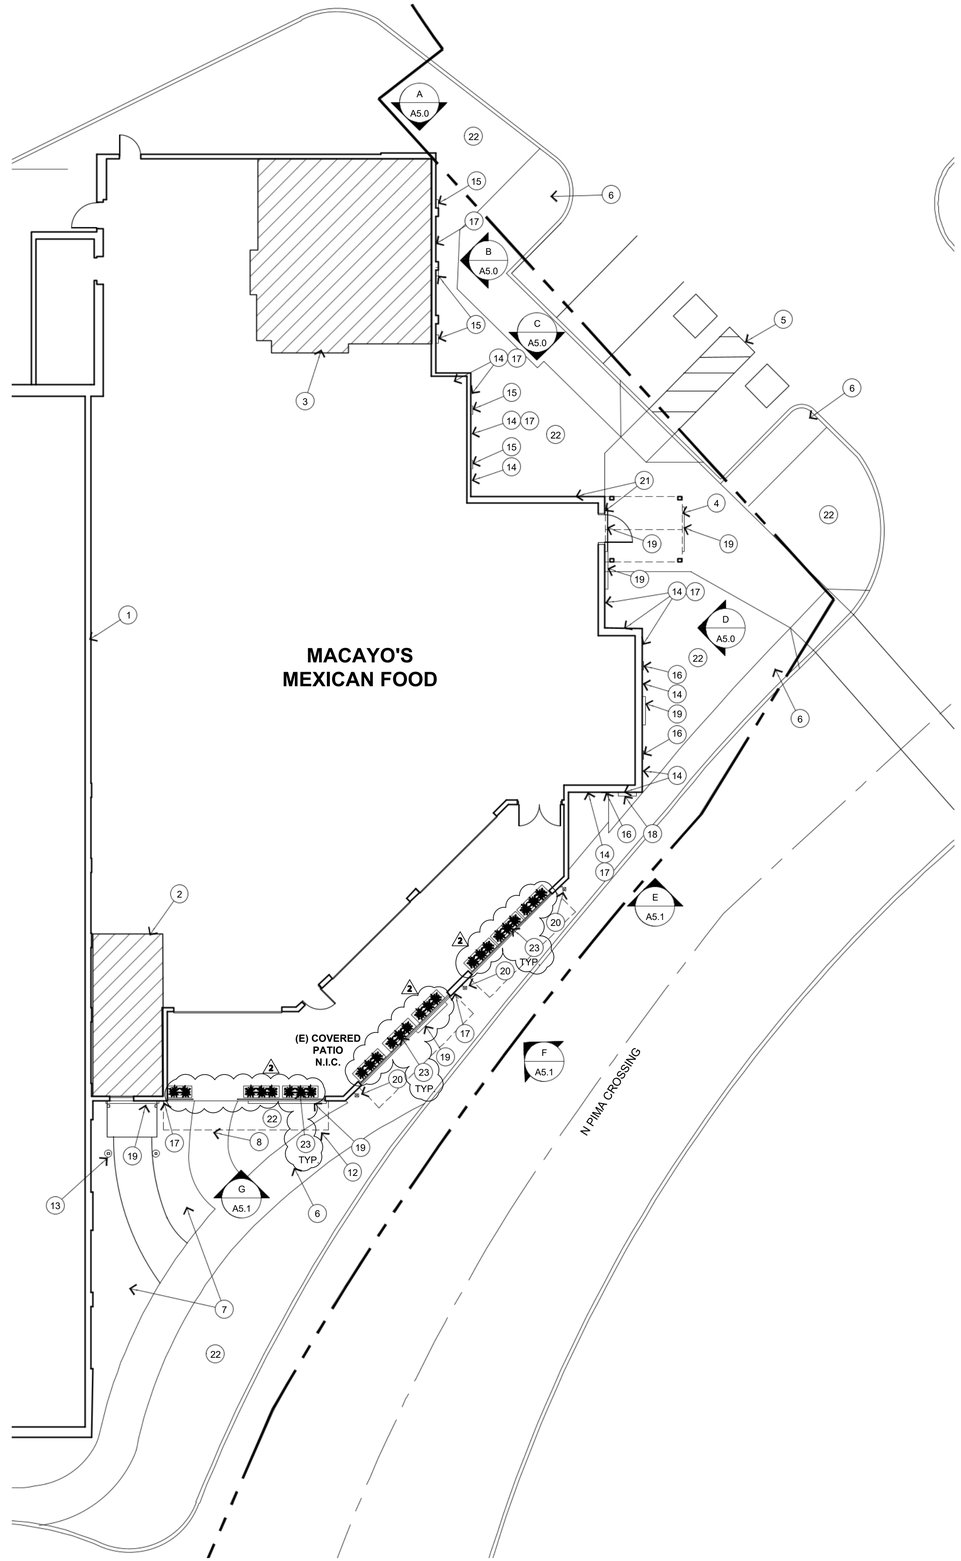

SCOPE OF WORK PLAN

SCALE: 1"=10'-0"

NORTH

KEYED NOTES

1. LEASE LINE
2. NEW TO-GO AREA W/ NEW EXTERIOR ENTRANCE. REFER TO SHEETS A1.0 & A2.0 FOR INTERIOR SCOPE OF WORK. SEE PLAN BELOW & SHEET A0.1 FOR EXTERIOR WORK.
3. EXISTING RESTROOMS. REFER TO SHEETS A3.0 & A4.0 FOR SCOPE OF WORK.
4. EXISTING COVERED MAIN ENTRANCE STRUCTURE. RELOCATE WALL MOUNTED EMERGENCY LIGHT TO BEAM ABOVE DOOR. REPLACE CEILING LIGHT W/ NEW PROVIDED BY OWNER.
5. EXISTING ACCESSIBLE PARKING.
6. EXISTING CONCRETE SIDEWALK, TO REMAIN.
7. EXISTING LANDSCAPE AREA. AT NEW TO-GO ENTRANCE, G.C. TO MODIFY PLANTING & IRRIGATION, AS REQUIRED BY NEW SIDEWALK & TRELLIS.
8. EXISTING CONCRETE SIDEWALK FROM PATIO.
9. NEW 4" CONCRETE LANDING AT DOOR W/ MAX. 2% SLOPE AWAY FROM BUILDING.
10. NEW CURVED 4" CONCRETE SIDEWALK W/ MAX. 5% SLOPE TO EXISTING SIDEWALK AND MAX. 2% CROSS SLOPE, TYP..
11. NEW TO-GO ENTRY DOOR & FRAME.
12. EXISTING STEEL CANOPIES ABOVE PATIO OPENINGS TO REMAIN. G.C. TO SEAL AS REQ'D., TYP. OF (3).
13. NEW TO-GO ENTRANCE TRELLIS STRUCTURE. REFER TO SHEET A0.1 FOR MORE INFORMATION.
14. EXISTING CORRUGATED METAL WALL PANELS TO BE REMOVED.
15. EXISTING BRICK VENEER COLUMN TO REMAIN, W/ NEW PAINT FINISH. REPLACE WALL SCONCE W/ NEW, PROVIDED BY OWNER.
16. EXISTING BRICK VENEER COLUMN TO BE REMOVED. PREP WALL FOR STUCCO INFILL, AS REQUIRED.
17. ALL EXISTING STUCCO TO BE PATCHED AND SMOOTHED AS REQUIRED TO RECEIVE PAINTED STENCIL APPLICATION, WHERE OCCURS. REFER TO EXT. ELEVATIONS.
18. EXISTING ADDRESS NUMBERS TO BE RE-INSTALLED AFTER CORRUGATED METAL PANELS ARE REMOVED.
19. LOCATION OF NEW INTERNALLY ILLUMINATED EXTERIOR SIGNAGE BY OWNER'S SIGN VENDOR, UNDER SEPARATE PERMIT. G.C. TO PROVIDE NEW POWER. COORD. BOX LOCATION W/ SIGN CO., TYP..
20. NEW WALL SCONCE BY OWNER TO BE INSTALLED ON EXISTING COVERED J-BOX.
21. EXISTING BRICK VENEER WALL TO REMAIN, W/ NEW PAINT FINISH. REFER TO ELEVATIONS.
22. EXISTING LANDSCAPED AREA TO REMAIN.
23. NEW CUSTOM OUTDOOR PLANTER. BLACKENED STEEL METAL, EXTERIOR RATED.

GENERAL NOTES

1. THESCOPE OF DEMOLITION SHALL INCLUDE ALL ITEMSINDICATED ON PLANS AND ALL OTHER ITEMS REQUIRED TO BE DEMOLISHED IN ORDER TO FACILITATE ALL NEW WORK AS INDICATED IN THE CONTRACT DOCUMENTS.
2. CARE SHALL BE TAKEN DURING CONSTRUCTION SO AS NOT TO DAMAGE OR ALTER ANY EXISTING STRUCTURAL MEMBERS. THE ARCHITECT & OWNER SHALL BE NOTIFIED IMMEDIATELY IF ANY DAMAGE OCCURS OR IS DISCLOSED DURING DEMOLITION.
3. THE CONTRACTOR SHALL PROMPTLY REMOVE ALL CONSTRUCTION WASTE AND DEBRIS FROM THE SITE. ALL CONSTRUCTION WASTE AND DEBRIS SHALL BE DISPOSED OF IN ACCORDANCE WITH ALL APPLICABLE LAWS AND ORDINANCES.
4. THE CONTRACTOR SHALL BE RESPONSIBLE FOR ANY DAMAGES CAUSED BY THE CONTRACTORS, BY THE ACTIONS OF THEIR SUBCONTRACTORS, OR THE ACTIONS OF THEIR VENDORS.
5. THE CONTRACTOR SHALL CLEAN, REPAIR AND RESTORE ALL EXISTING FINISHES SCHEDULED TO REMAIN AFFECTED BY THE SCOPE OF WORK.
6. ALL SIDEWALK TRANSITIONS SHALL BE FLUSH.

CITY OF SCOTTSDALE
BUILDING PLANS
THESE PLANSHAVE BEENREVIEWED
AND ARE READY FOR APERMIT.
THIS DOES NOT AUTHORIZE VIOLATIONS OF ANY
CODE OR ORDINANCE.

SCALE:	AS NOTED
DRAWN BY:	DLT
DATE:	01.18.21
PROJECT NUMBER:	20-149.01

#	DATE:	DESCRIPTION:
2	04.02.21	PLANNING COMMENTS

Macayo's Mexican Food

kind HOSPITALITY

PROJECT:
MACAYO'S MEXICAN FOOD
SCOTTSDALE LOCATION
8560 E. PINNACLE PEAK ROAD
SCOTTSDALE, ARIZONA 85255

SHEETTITLE:
TO-GO - EXTERIOR PLAN
SCOPE OF WORK PLAN

BUILDING PLANCHECK #1415-21

ideation DESIGN GROUP
4855 EAST WASHINGTON STREET PHOENIX, ARIZONA 85034
tel 602.792.7781 fax 602.792.1846
INTERIOR DESIGN FOOD SERVICE DESIGN ARCHITECTURE

SUBMITTAL ISSUE - 02.09.2021

REGISTERED ARCHITECT
CERTIFICATE NO.
66613
DEBORAH LEE
STATE OF ARIZONA
DATE SIGNED
EXPIRES 06.30.21

SHEETNO:
A0.1