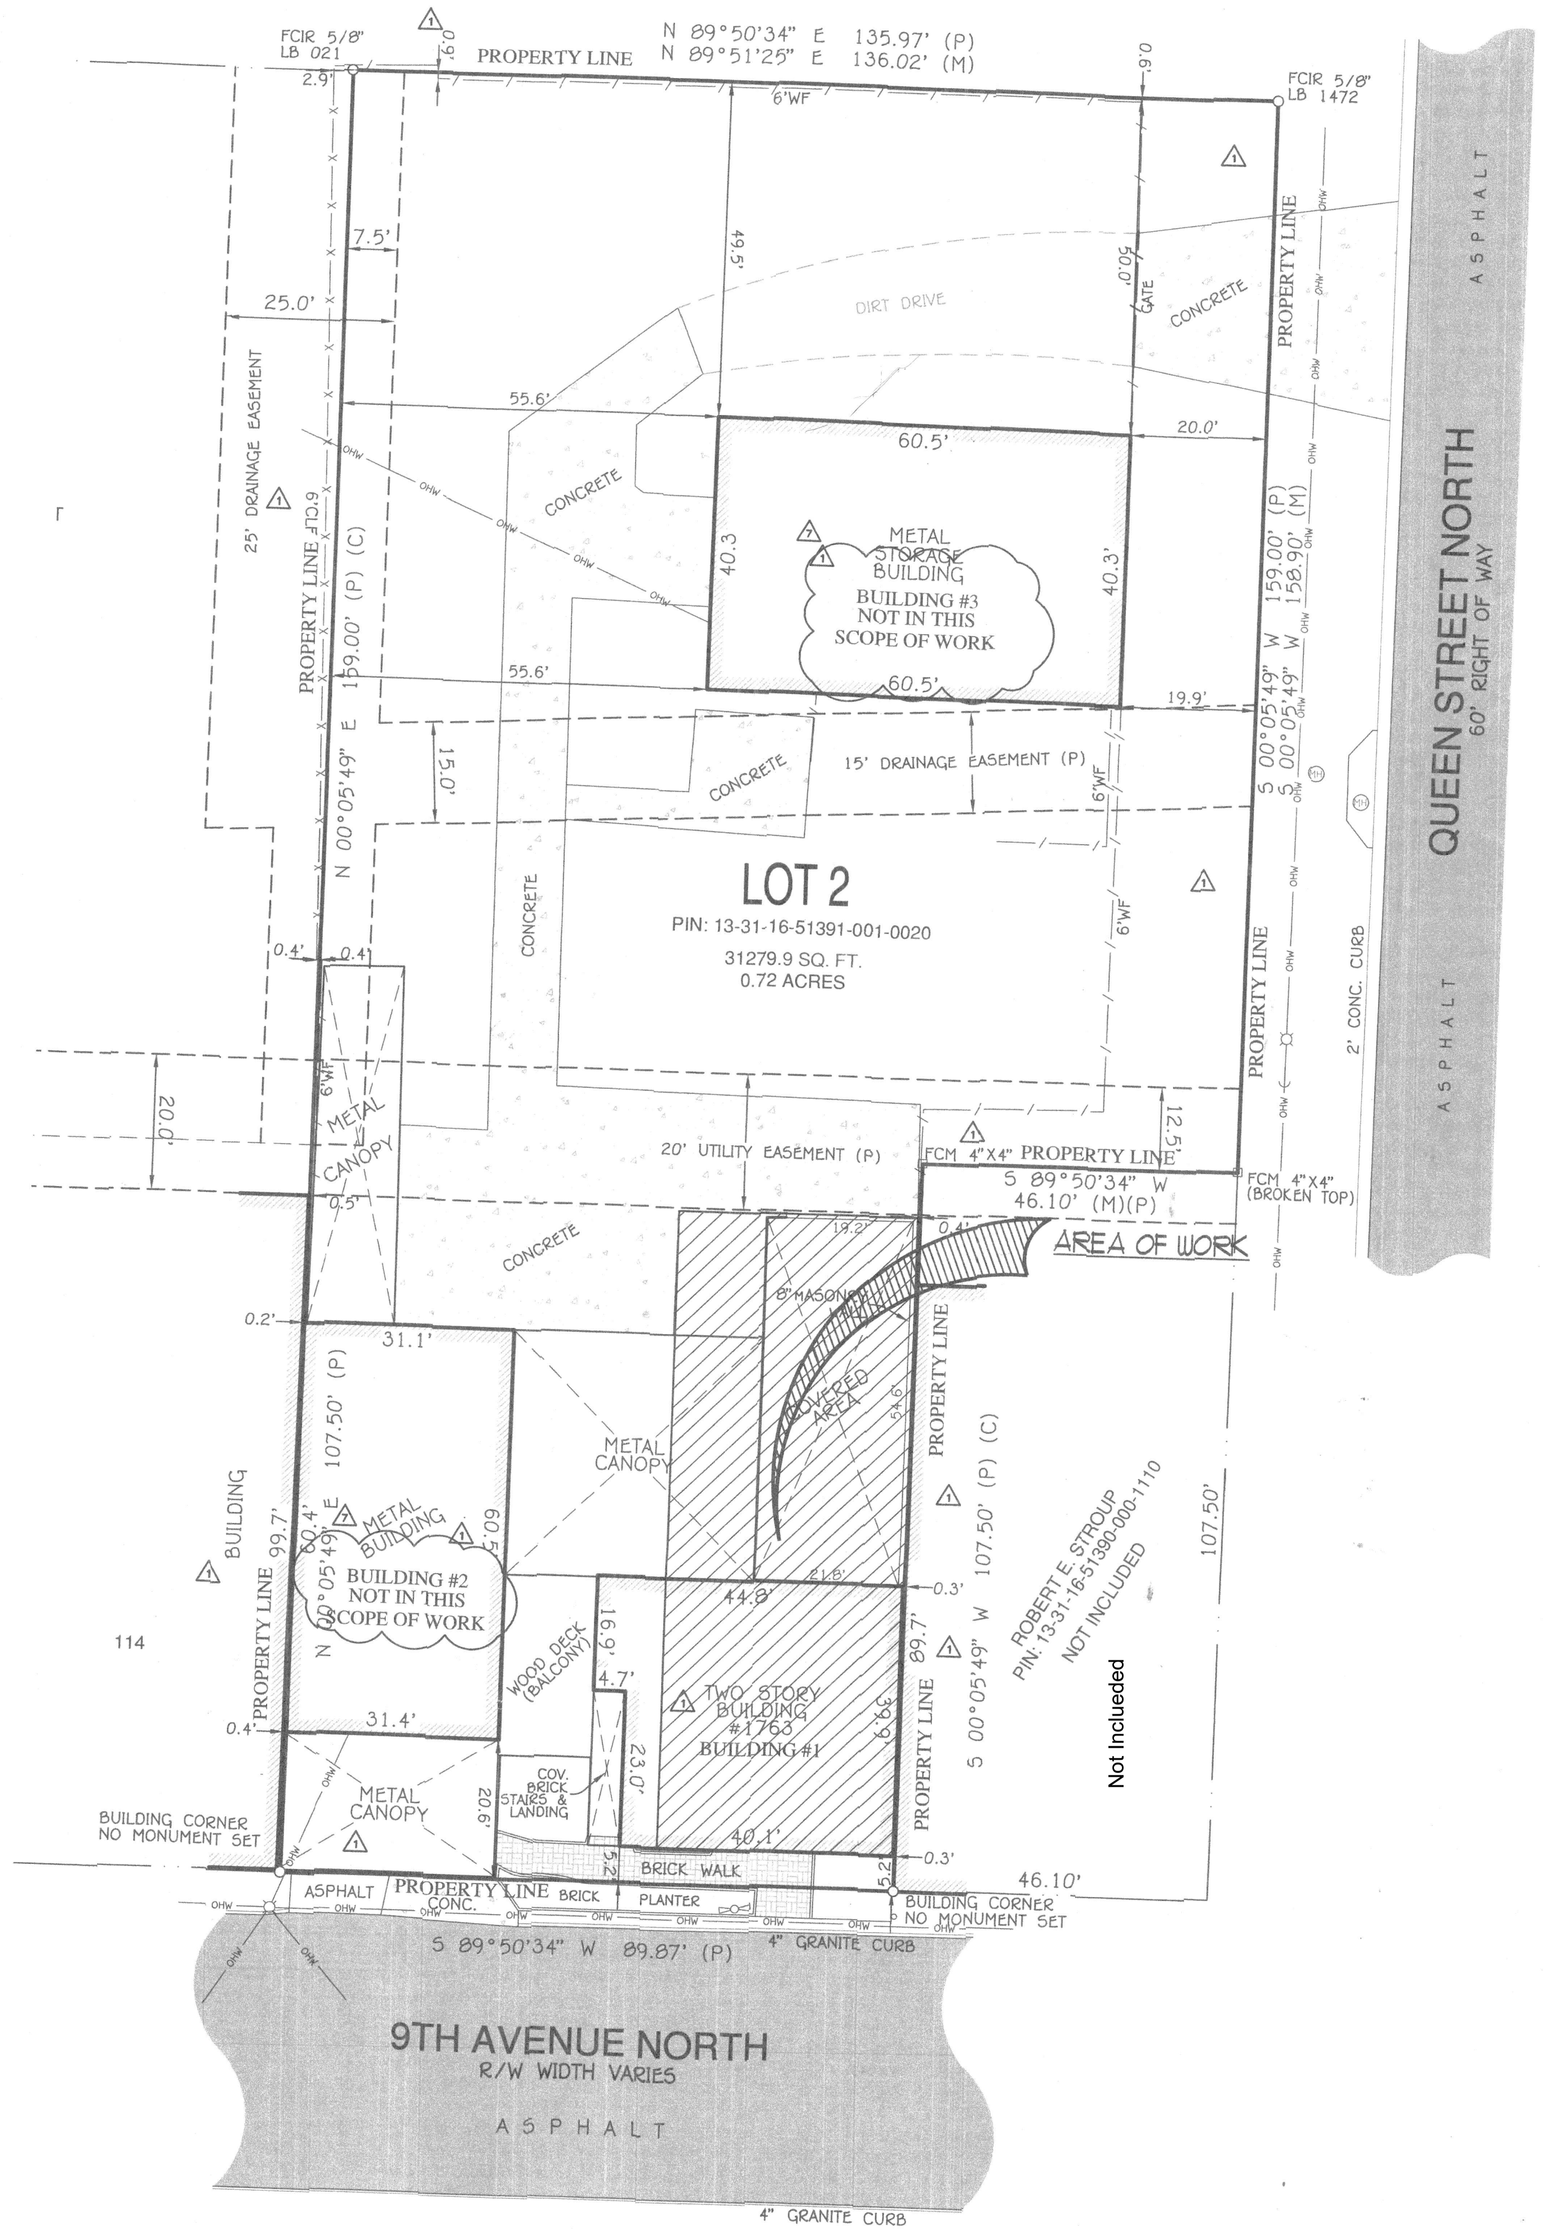

1 ARCHITECTURAL SITE PLAN

SCALE: 1/16" - 1'-0"

THESE DOCUMENTS, DESIGNS, NOTES, DETAILS AND SPECIFICATIONS AND CONCEPTS ARE THE SOLE PROPERTY OF FRAZE DESIGN, INC. AND SHALL NOT BE REPRODUCED, RE-USED OR COPIED FOR OTHER PROJECTS, IN WHOLE OR PART WITHOUT THE WRITTEN CONSENT OF FRANK FRAZE, ARCHITECT, AIA.

ALL RIGHTS ARE RESERVED BY THE ARCHITECT IN ACCORDANCE WITH U.S. COPYRIGHT AND PATENT LAWS. UNAUTHORIZED REPRODUCTION WILL BE PROSECUTED TO THE FULL EXTENT OF THE LAW.

* THE DRAWINGS & DESIGN ARE VALID FOR 12 MONTHS FROM DATE OF BEING SEALED.

TO THE BEST OF THE ARCHITECT OR ENGINEER'S KNOWLEDGE AND BELIEF, THESE PLANS AND SPECIFICATIONS COMPLY WITH THE 8TH EDITION 2023 FLORIDA BUILDING CODE IN ADDITION TO ANY OTHER APPLICABLE BUILDING CODES AND MINIMUM FIRE SAFETY STANDARDS

ALL DIMENSIONS AND JOB CONDITIONS SHALL BE VERIFIED BY THE

		DATE
REV.	REVIEW	07/24
REV.	PERMIT	07/24
REV.		07/24
REV.		
REV.		
REV.		08/02/24
REV.	Plan Reviewed for Code Compliance By:	07/25/24 MK
REV.		

City of St. Petersburg Florida
24-02001243
08/02/24

MEMBER OF AIA American Institute of Architects

FD# 24006.00.00

Construction Documents fo.:

SUNCOAST HAVEN
1763 9TH AVENUE NORTH
ST. PETERSBURG, FLORIDA

Digitally signed by Ora F. Fraze
Date: 202 09:4

commercial residential

FRAZE design
E-MAIL: fd@frazedesign.com
1750 CENTRAL AVENUE
PHONE: 727/328-3608
ST. PETERSBURG
FAX: 727/328-3609

COPYRIGHT 2024 FRAZE DESIGN, INC. - FRANK FRAZE AIA NCARB

SHEET TITLE
ARCHITECTURAL SITE PLAN

SHEET NUMBER
A-2