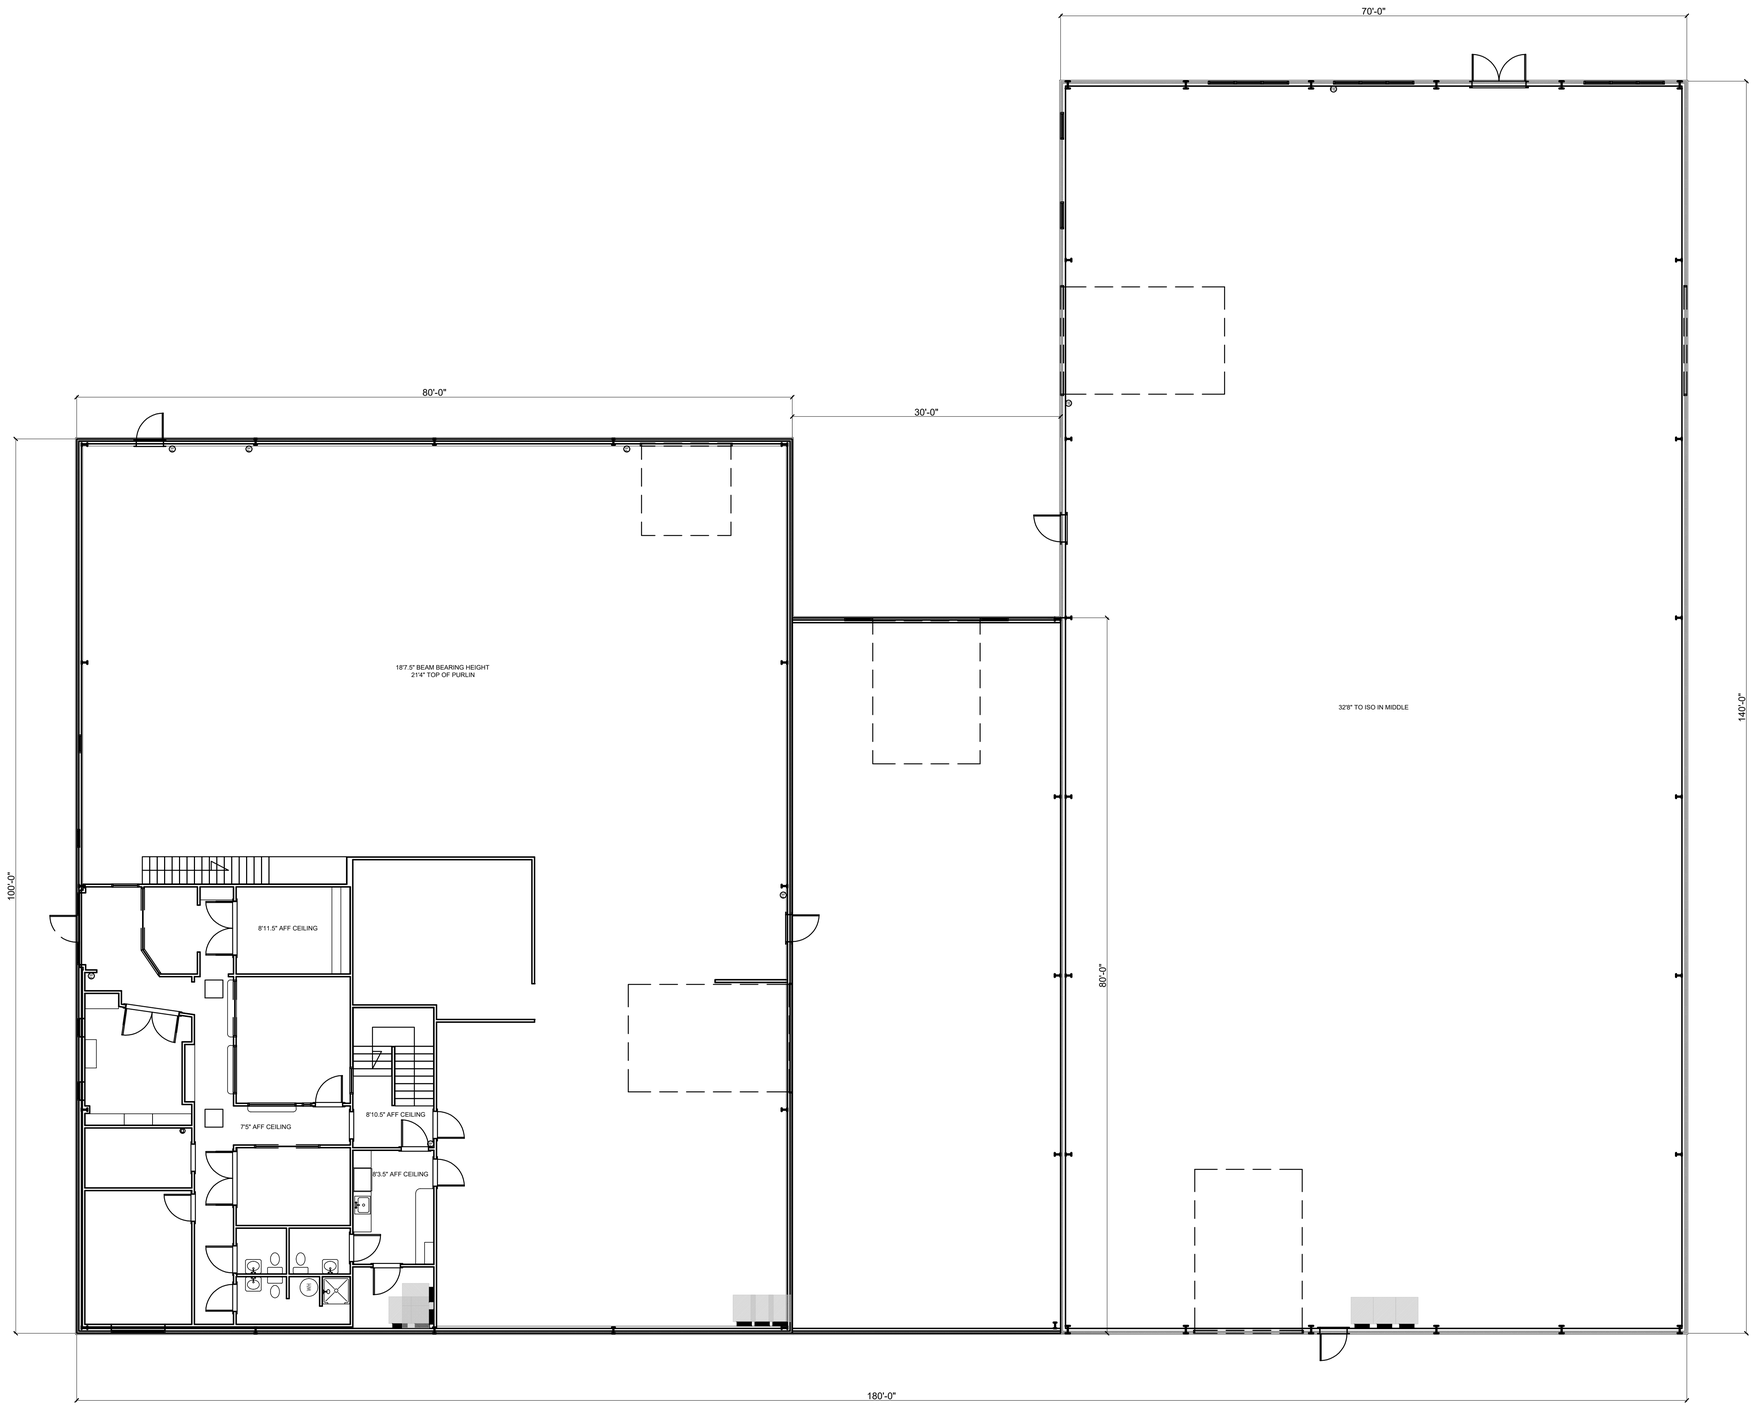

1 DIMENSIONED FLOOR PLAN
SCALE : 1/8" = 1'0"

ISLANDS ARCHITECTURE & DESIGN

CLIENT
11328 BUSINESS PARK BLVD, LLC

SHEET TITLE
AB-FLOOR

11328 BUSINESS PARK BLVD, LLC
11328 BUSINESS PARK BLVD.
JACKSONVILLE, FL 32256

NO.	BY	DATE	DESCRIPTION

REVISIONS

ISSUE FOR PERMIT

CHECKED BY:	JMB
DRAWN BY:	JMB,JPB,SMB
ISSUE DATE:	

AB-FLOOR

THIS ARCHITECTURAL DRAWINGS IS GIVEN IN CONFIDENCE. NO USE OR DISSEMINATION MAY BE MADE WITHOUT PRIOR WRITTEN CONSENT OF THE ARCHITECT. ALL COMMON LAW RIGHTS OF COPYRIGHT AND OTHERWISE ARE HEREBY SPECIFICALLY RESERVED.

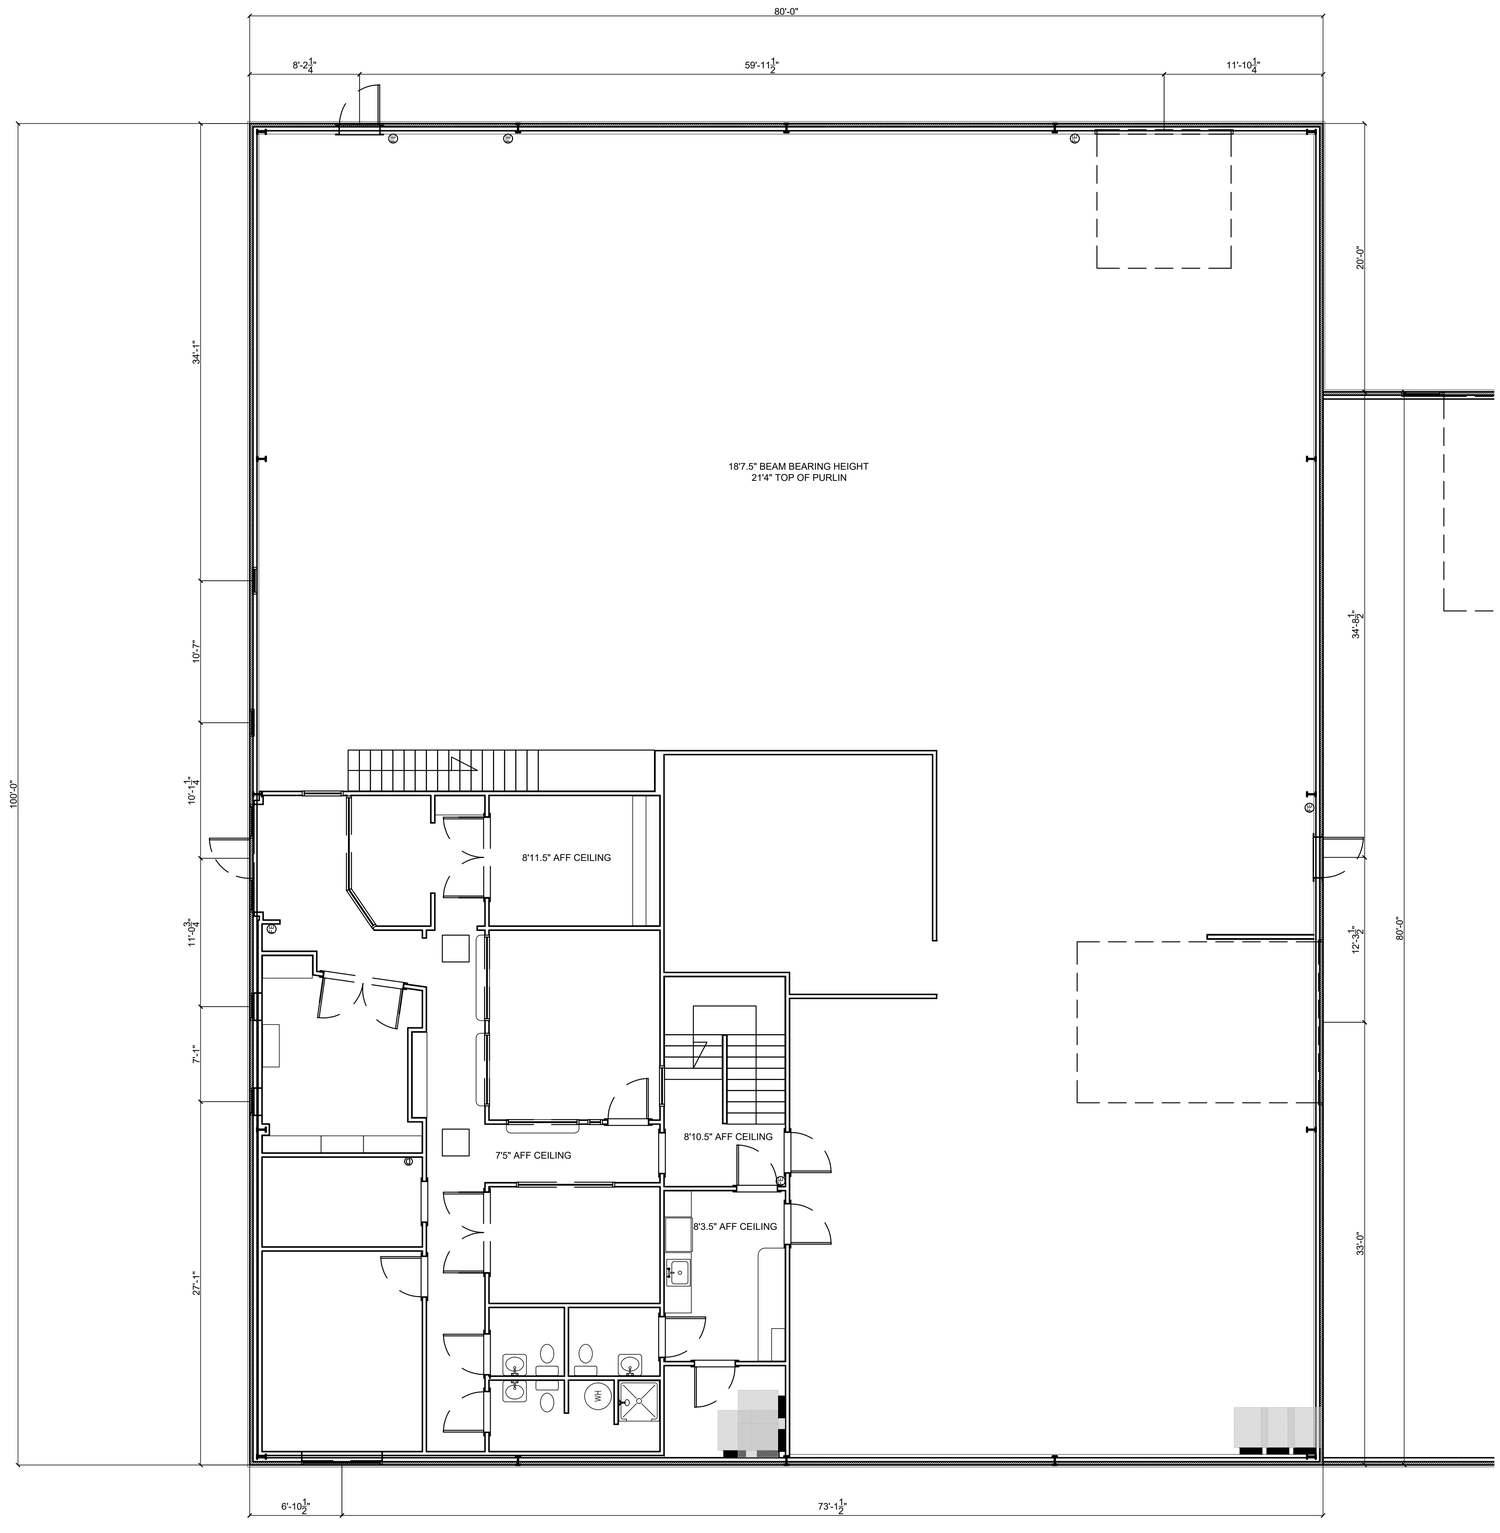

1 DIMENSIONED FLOOR PLAN - BUILDING SPACE 1
SCALE : 3/16" = 1'0"

ISLANDS ARCHITECTURE & DESIGN

CLIENT
11328 BUSINESS PARK BLVD, LLC

SHEET TITLE
AB-ENLARGED FLOOR

11328 BUSINESS PARK BLVD, LLC
11328 BUSINESS PARK BLVD.
JACKSONVILLE, FL 32256

NO.	BY	DATE	DESCRIPTION

REVISIONS

ISSUE FOR PERMIT

CHECKED BY:	JMB
DRAWN BY:	JMB,JPB,SMB
ISSUE DATE:	

AB-FLOOR 2

THIS ARCHITECTURAL DRAWINGS IS GIVEN IN CONFIDENCE. NO USE OR DISSEMINATION MAY BE MADE WITHOUT PRIOR WRITTEN CONSENT OF THE ARCHITECT. ALL COMMON LAW RIGHTS OF COPYRIGHT AND OTHERWISE ARE HEREBY SPECIFICALLY RESERVED.

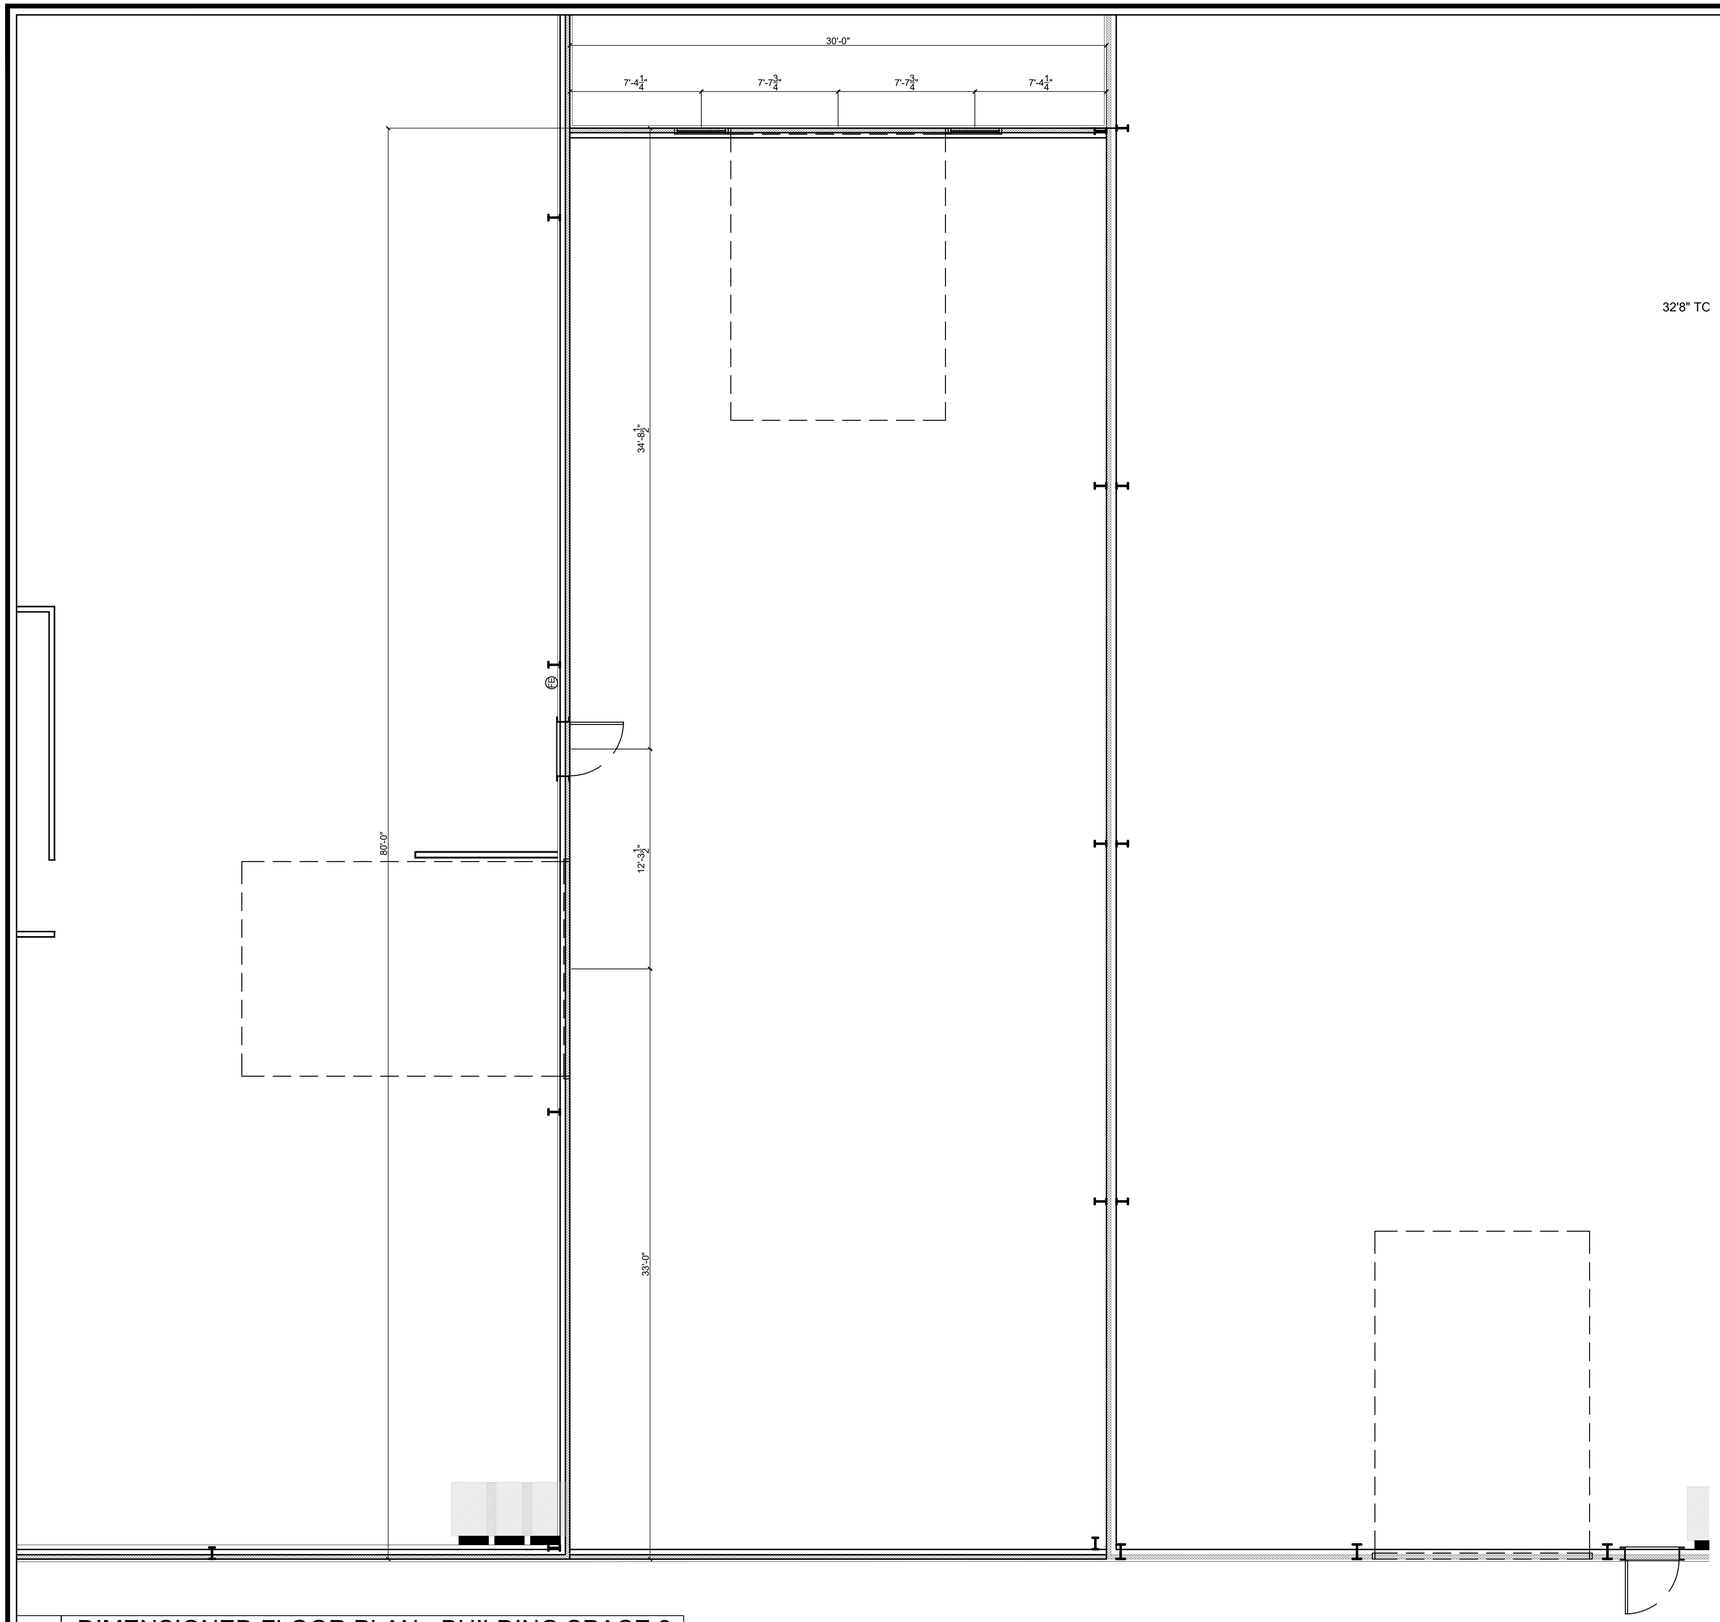

1 DIMENSIONED FLOOR PLAN - BUILDING SPACE 2
SCALE : 1/4" = 1'0"

ISLANDS ARCHITECTURE & DESIGN

CLIENT
11328 BUSINESS PARK BLVD, LLC

SHEET TITLE
AB-ENLARGED FLOOR

11328 BUSINESS PARK BLVD, LLC
11328 BUSINESS PARK BLVD.
JACKSONVILLE, FL 32256

NO.	BY	DATE	DESCRIPTION

REVISIONS

ISSUE FOR PERMIT

CHECKED BY:	JMB
DRAWN BY:	JMB,JPB,SMB
ISSUE DATE:	

AB-FLOOR 3

THIS ARCHITECTURAL DRAWINGS IS GIVEN IN CONFIDENCE. NO USE OR DISSEMINATION MAY BE MADE WITHOUT PRIOR WRITTEN CONSENT OF THE ARCHITECT. ALL COMMON LAW RIGHTS OF COPYRIGHT AND OTHERWISE ARE HEREBY SPECIFICALLY RESERVED.

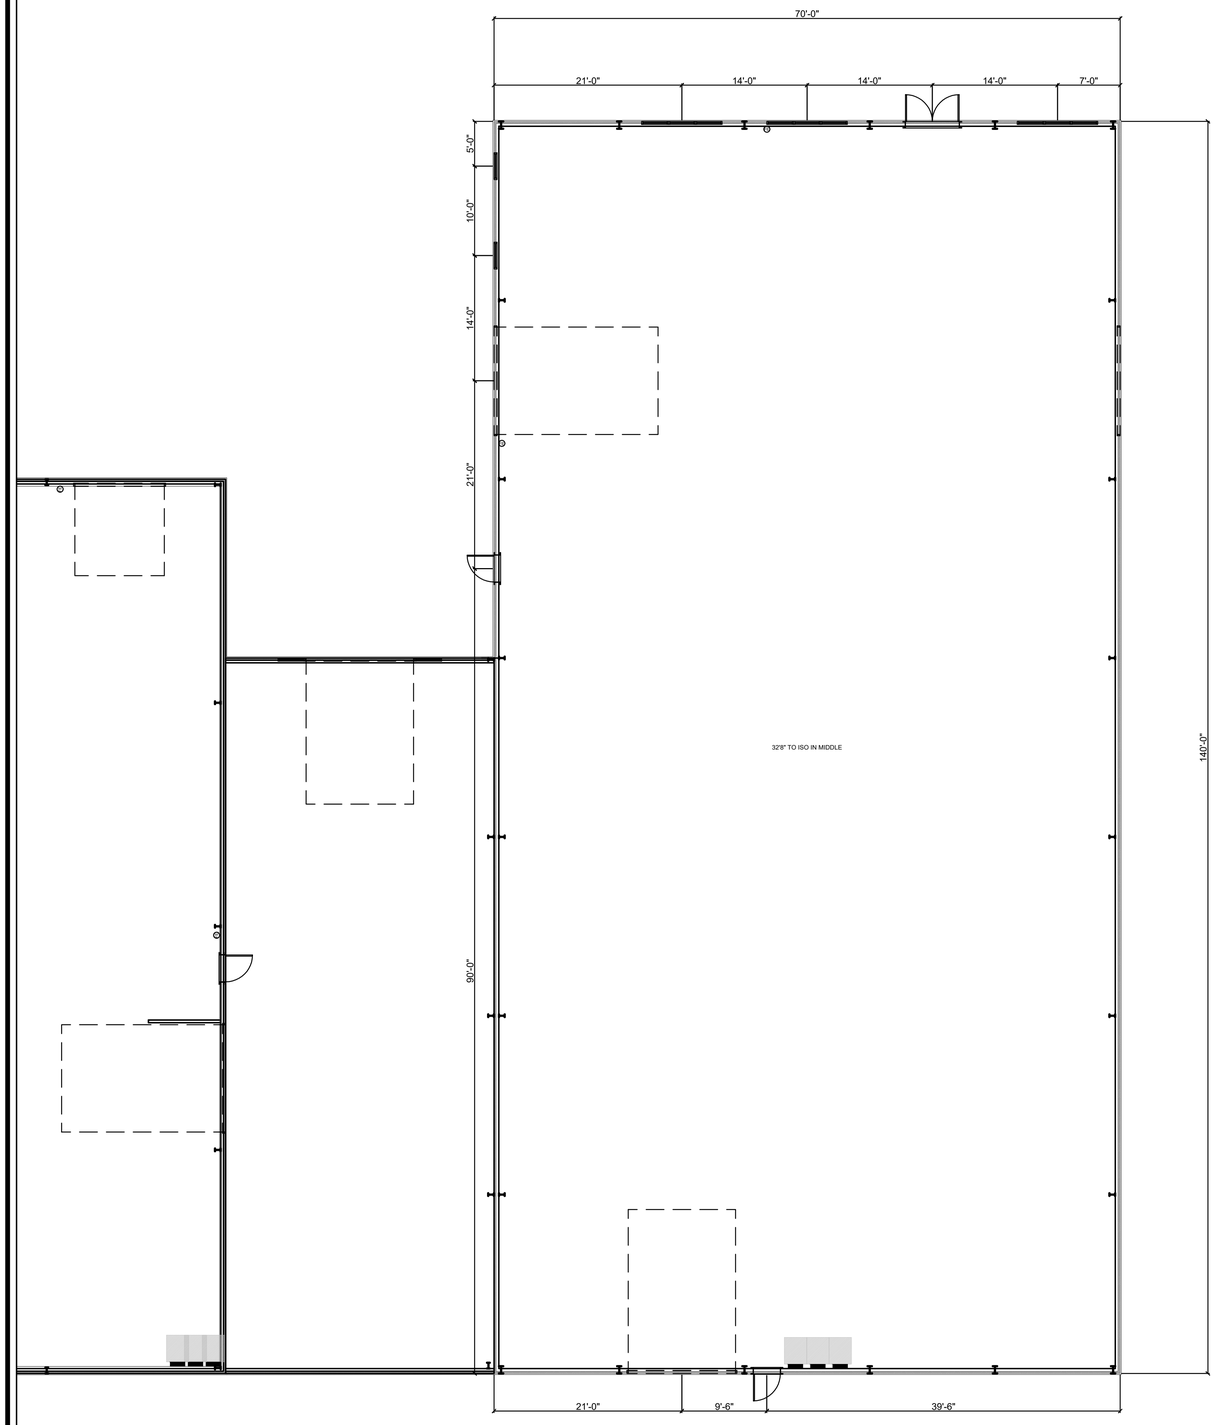

1 DIMENSIONED FLOOR PLAN - BUILDING SPACE 3
SCALE : 1/8" = 1'0"

ISLANDS ARCHITECTURE & DESIGN

CLIENT
11328 BUSINESS PARK BLVD, LLC

SHEET TITLE
AB-ENLARGED FLOOR

11328 BUSINESS PARK BLVD, LLC
11328 BUSINESS PARK BLVD.
JACKSONVILLE, FL 32256

NO.	BY	DATE	DESCRIPTION

REVISIONS

ISSUE FOR PERMIT

CHECKED BY:	JMB
DRAWN BY:	JMB,JPB,SMB
ISSUE DATE:	

AB-FLOOR 4

THIS ARCHITECTURAL DRAWINGS IS GIVEN IN CONFIDENCE . NO USE OR DISSEMINATION MAY BE MADE WITHOUT PRIOR WRITTEN CONSENT OF THE ARCHITECT . ALL COMMON LAW RIGHTS OF COPYRIGHT AND OTHERWISE ARE HERBY SPECIFICALLY RESERVED

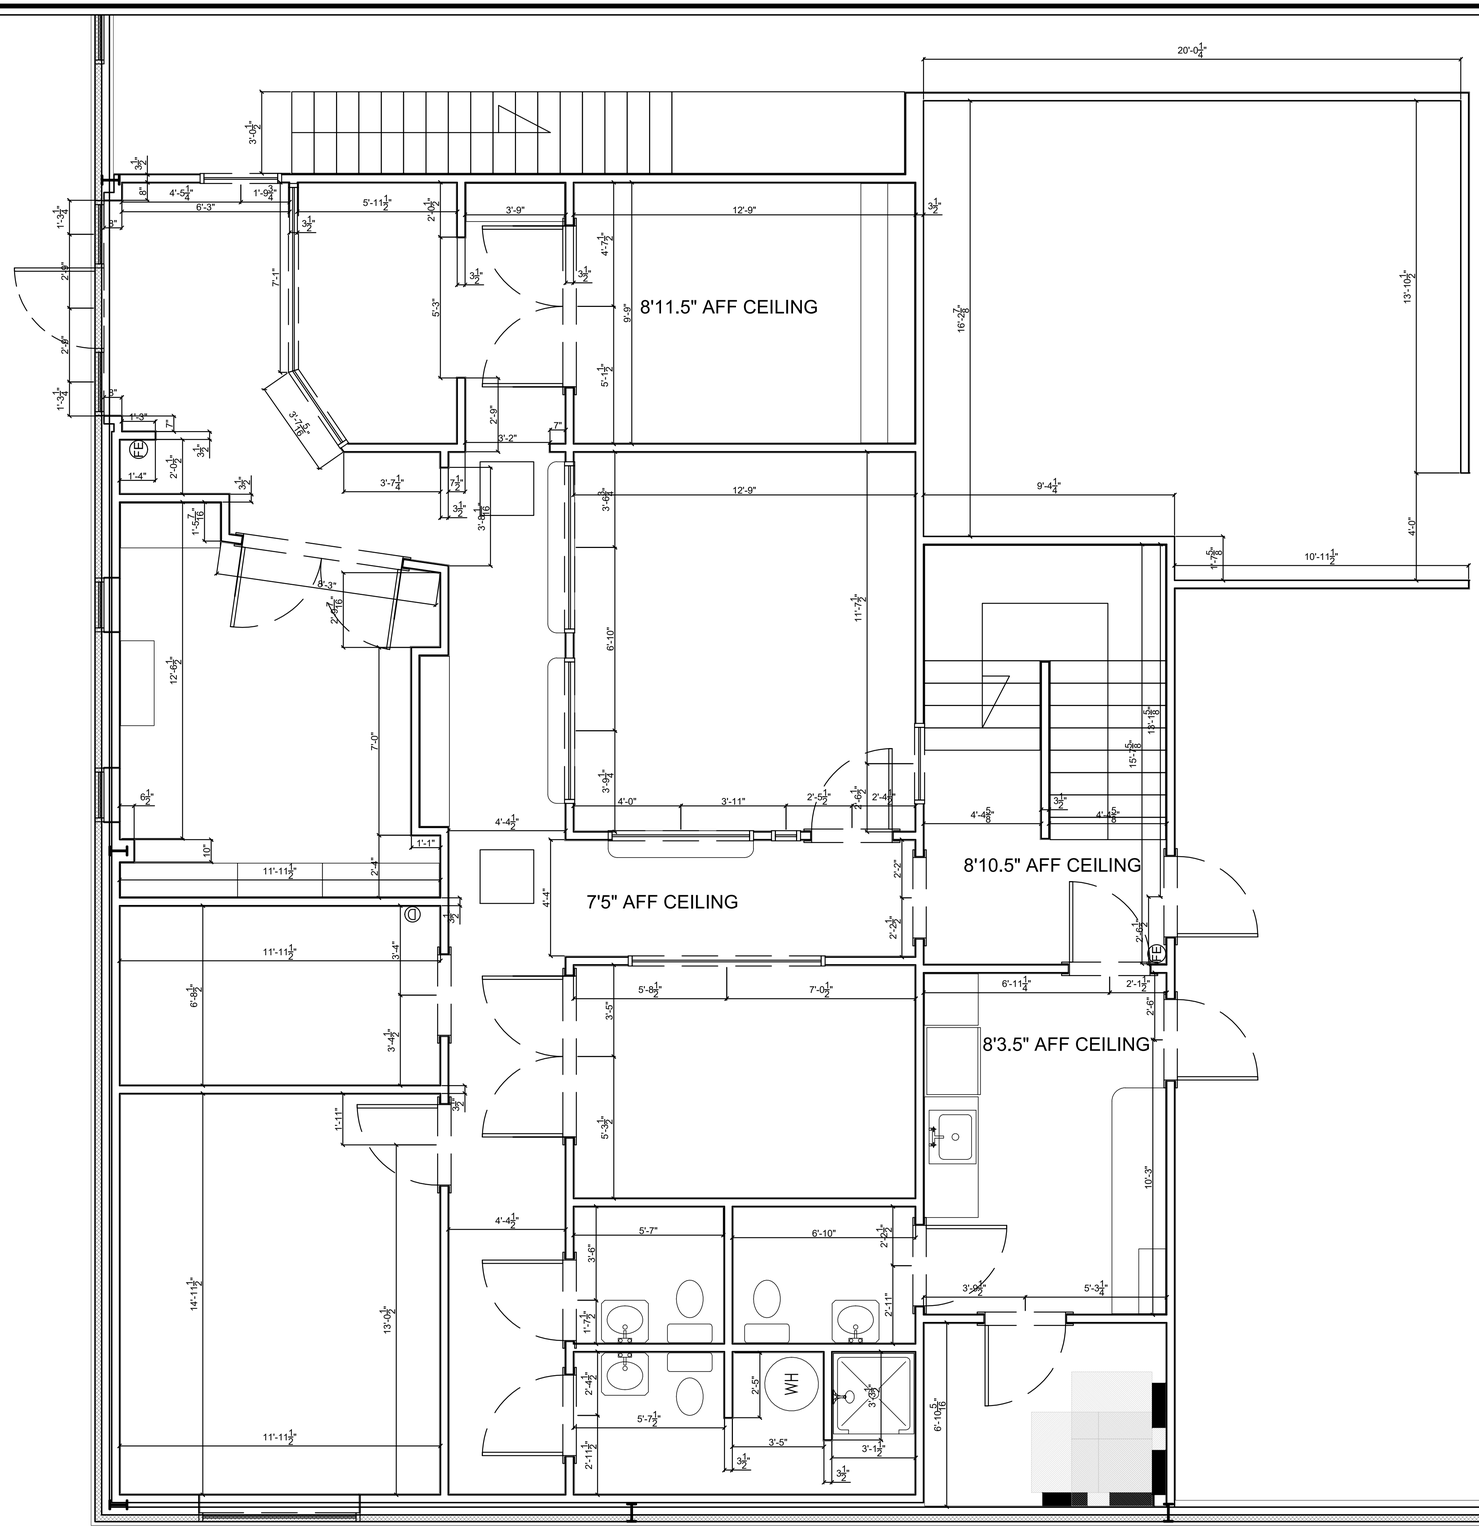

1 DIMENSIONED FLOOR PLAN - BUILDING SPACE 1 - 1ST FLOOR OFFICE
SCALE : 3/8" = 1'0"

ISLANDS ARCHITECTURE & DESIGN

CLIENT
11328 BUSINESS PARK BLVD, LLC

SHEET TITLE
AB-ENLARGED FLOOR

11328 BUSINESS PARK BLVD, LLC
11328 BUSINESS PARK BLVD.
JACKSONVILLE, FL 32256

NO.	BY	DATE	DESCRIPTION

REVISIONS

ISSUE FOR PERMIT

CHECKED BY:	JMB
DRAWN BY:	JMB,JPB,SMB
ISSUE DATE:	

AB-FLOOR 5

THIS ARCHITECTURAL DRAWINGS IS GIVEN IN CONFIDENCE. NO USE OR DISSEMINATION MAY BE MADE WITHOUT PRIOR WRITTEN CONSENT OF THE ARCHITECT. ALL COMMON LAW RIGHTS OF COPYRIGHT AND OTHERWISE ARE HERBY SPECIFICALLY RESERVED.

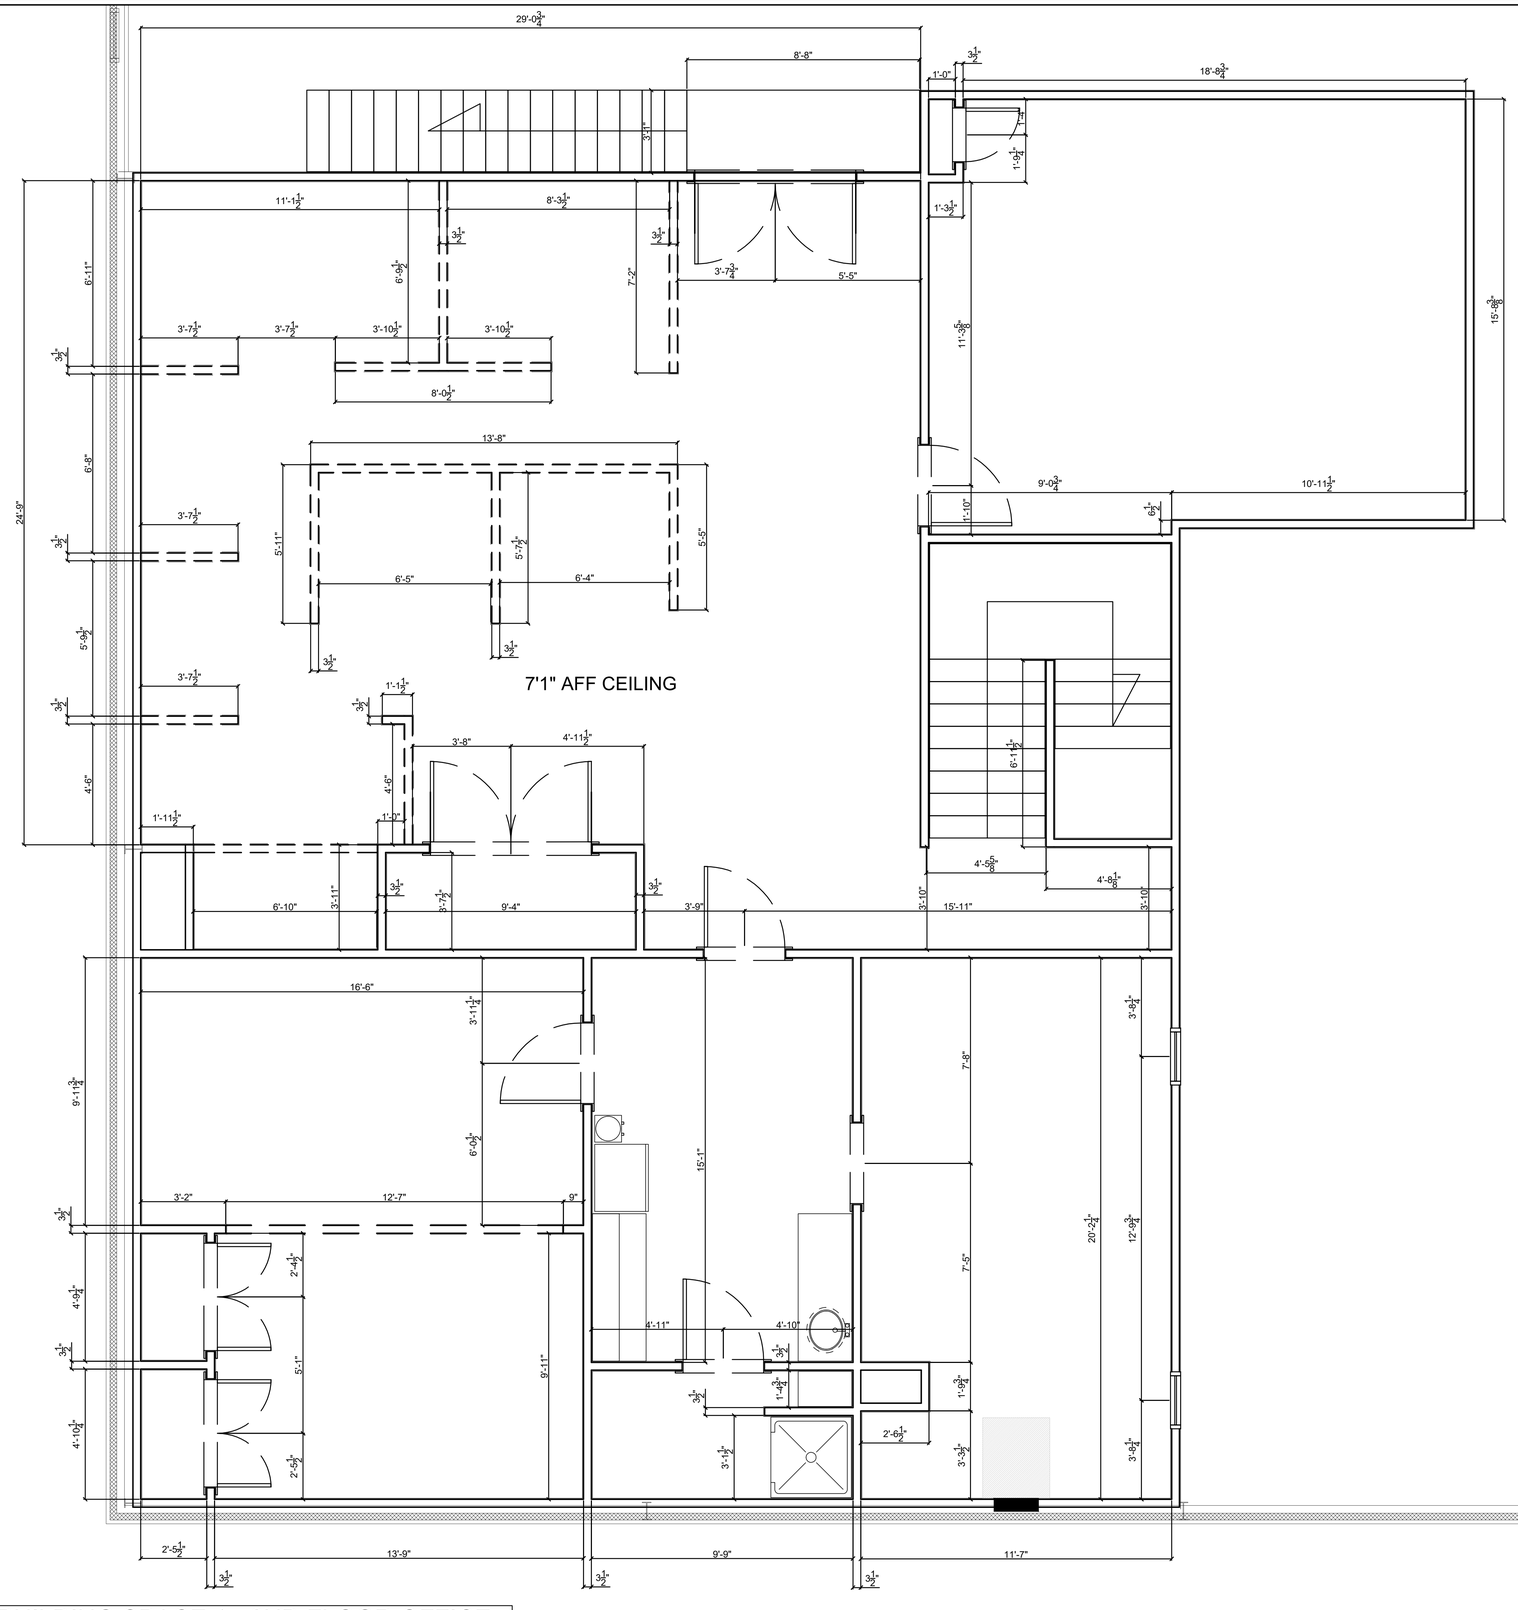

1 DIMENSIONED FLOOR PLAN - BUILDING SPACE 1 - 2ND FLOOR OFFICE
SCALE : 3/8" = 1'0"

ISLANDS ARCHITECTURE & DESIGN

CLIENT
11328 BUSINESS PARK BLVD, LLC

11328 BUSINESS PARK BLVD, LLC
11328 BUSINESS PARK BLVD.
JACKSONVILLE, FL 32256

SHEET TITLE
AB-ENLARGED FLOOR

NO.	BY	DATE	DESCRIPTION

REVISIONS

ISSUE FOR PERMIT

CHECKED BY:	JMB
DRAWN BY:	JMB,JPB,SMB
ISSUE DATE:	

THIS ARCHITECTURAL DRAWINGS IS GIVEN IN CONFIDENCE. NO USE OR DISSEMINATION MAY BE MADE WITHOUT PRIOR WRITTEN CONSENT OF THE ARCHITECT. ALL COMMON LAW RIGHTS OF COPYRIGHT AND OTHERWISE ARE HERBY SPECIFICALLY RESERVED.